

Map No. _____ Sec. 20 Twp. 28 R. 4
 Well No. 11 Blood Farm _____
Mid Kansas Company _____

NORTH

WEST



EAST

SOUTH

Location _____

Rig Up _____

Drilling Remarks:

Drilling Remarks:

7/25 Completed.

200 bbl.

RECORD

Cased _____ in _____ Ft.

Sand _____

Gas _____

Oil _____

Total Depth _____

PRODUCTION

1st 24 hrs. Nat. _____

1st 24 hrs. after shot _____

Gas _____ Cu. Ft.

Dry Hole _____

Abandoned _____

Form T-135—R-9-29-15—300 Books of 100 Dup.


Map No. _____ Sec. 20 Twp. 28 R. 4

Well No. 8 Blowel Farm

Mid Kansas Company

NORTH

WEST

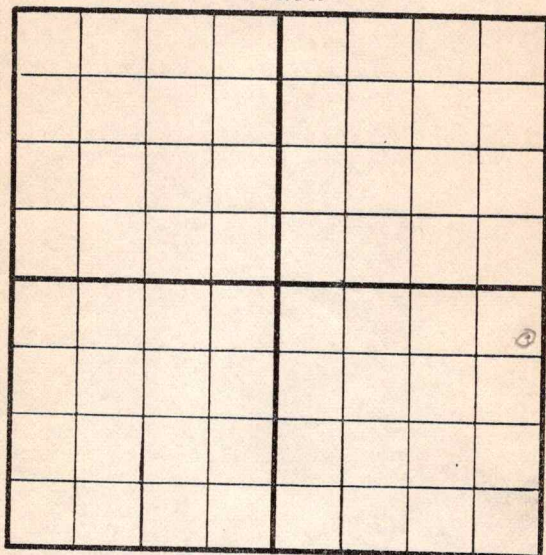

EAST

SOUTH

Location _____

Rig up _____

Drilling and remarks _____

RECORD

Cased _____ in. _____ Ft.

Sand _____

Gas _____

Oil _____

Total Depth _____

PRODUCTION

1st 24 hrs. Nat. _____

1st 24 hrs. after shot _____

Gas _____ Cu. Ft.

Dry Hole _____

Abandoned _____

Date


4/6, 1916, Kirceland Scout

Map No. _____ Sec. 20 Twp. 28 R. 4
 Well No. 8 L. A. Blood Farm _____
Mid-Kansas Company _____

NORTH

WEST

EAST

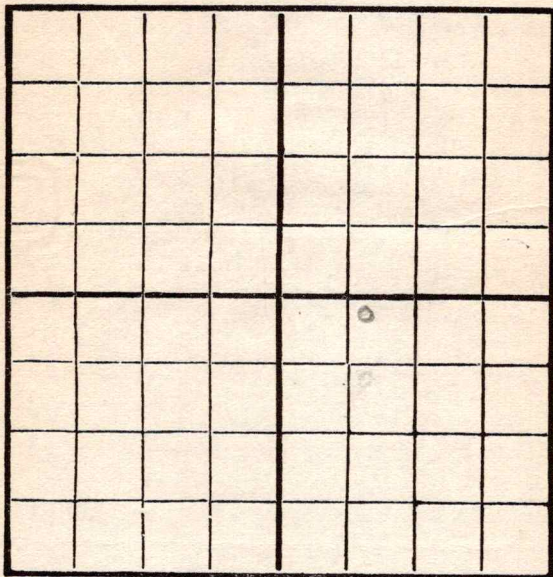

SOUTH

Location _____

Rig Up _____

Drilling and remarks

*Drilling at
700 ft*

RECORD

Cased _____ in. _____ Ft.

Sand _____

Gas _____

Oil _____

Total Depth _____

PRODUCTION

1st 24 hrs. Nat. _____

1st 24 hrs. after shot _____

Gas _____ Cu. Ft.

Dry Hole _____

Abandoned _____

Date


Apr 29, 1916 L. A. Blood Scout

Map No. _____ Sec. 22 Twp. 28 R. 4Well No. 8 L.A. Beach Farm _____Mid-Kansas Oil Company _____

NORTH

WEST

EAST

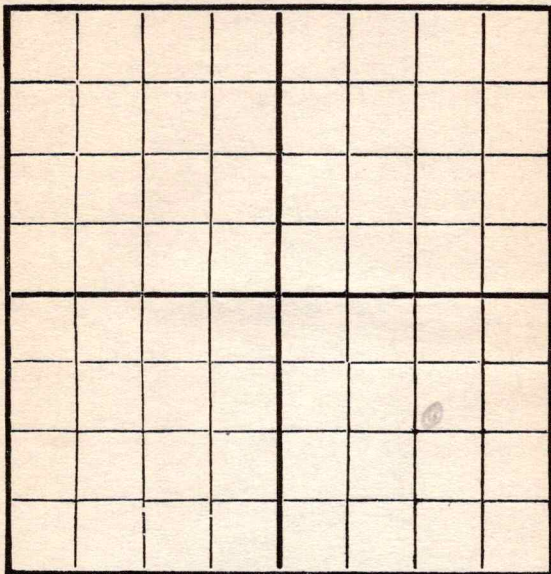

SOUTH

Location _____

Rig Up _____

Drilling and remarks

728

RECORD

Cased _____ in. _____ Ft.

Sand _____

Gas _____

Oil _____

Total Depth _____

PRODUCTION

1st 24 hrs. Nat. _____

1st 24 hrs. after shot _____

Gas _____ Cu. Ft.

Dry Hole _____


Abandoned _____

Date

May 1, 1916 L.A. Beach Scout

Map No. _____ Sec. 20 Twp. 28 R. 4
 Well No. 8 L.A. Block Farm _____
Mid Kansas Company _____

NORTH

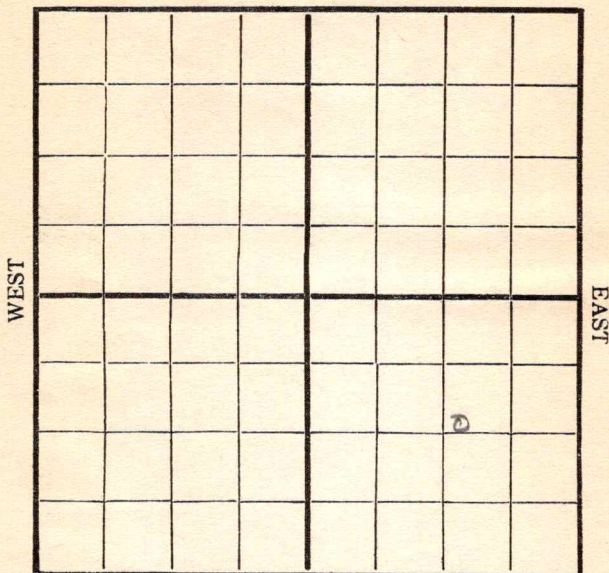

SOUTH

Location _____
 Rig Up _____
 Drilling and remarks _____

1350 ft

RECORD

Cased _____ in. _____ Ft.
 Sand _____
 Gas _____
 Oil _____
 Total Depth _____

PRODUCTION

1st 24 hrs. Nat. _____
 1st 24 hrs. after shot _____
 Gas _____ Cu. Ft.
 Dry Hole _____
 Abandoned _____

Date


5/8, 191 L.A. Block Scout

Map No. _____ Sec. 20 Twp. 28 R. 4
 Well No. L. L. A. Blund Farm _____
Mid Kansas Company _____

NORTH

WEST

EAST

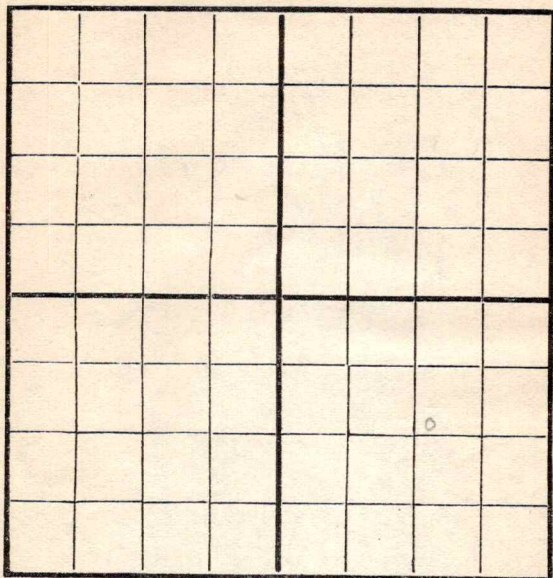

SOUTH

Location _____
 Rig Up _____
 Drilling and remarks _____

RECORD

Cased _____ in. _____ Ft.
 Sand _____
 Gas _____
 Oil _____
 Total Depth _____

PRODUCTION


1st 24 hrs. Nat. _____
 1st 24 hrs. after shot _____
 Gas _____ Cu. Ft.
 Dry Hole _____
 Abandoned _____

Date

5/22, 1916 L. L. A. Blund Scout

Map No. _____ Sec. 20 Twp. 28 R. 4
 Well No. 11 Blood Farm _____
Mid Kansas Company _____

NORTH

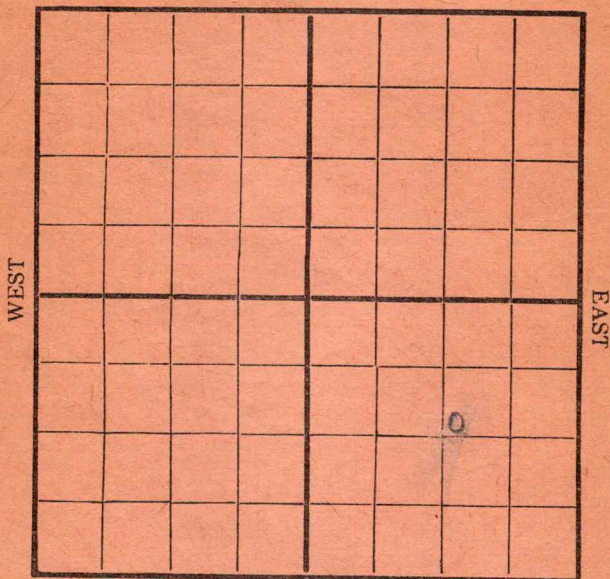

SOUTH

Location _____
 Rig Up _____
 Drilling and remarks _____

Drilling
✓

RECORD

Cased _____ in. _____ Ft.
 Sand _____
 Gas _____
 Oil _____
 Total Depth _____

PRODUCTION


1st 24 hrs. Nat. _____
 1st 24 hrs. after shot _____
 Gas _____ Cu. Ft.
 Dry Hole _____
 Abandoned _____

Date

6/30, 1916. Blood Scout

Map No. _____ Sec. 20 Twp. 38 R. 4
 Well No. 11 Blood Farm _____
and Run Company _____

NORTH

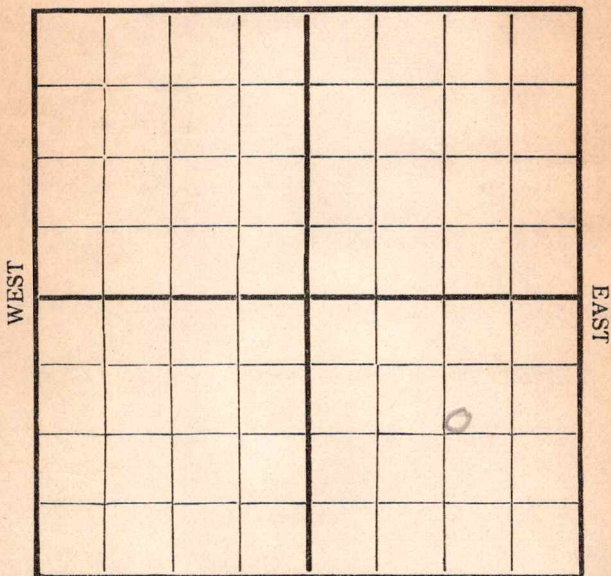

SOUTH

Location _____

Rig Up _____

Drilling and remarks

700'

RECORD

Cased _____ in. _____ Ft.

Sand _____

Gas _____

Oil _____

Total Depth _____

PRODUCTION

1st 24 hrs. Nat. _____

1st 24 hrs. after shot _____

Gas _____ Cu. Ft.

Dry Hole _____

Abandoned _____

Date

7/3

191

L. McCarty


Scout

Map No. _____ Sec. 20 Twp. 28 R. 4
 Well No. 11 Blount Farm _____
and Thomas Company

NORTH

WEST

EAST

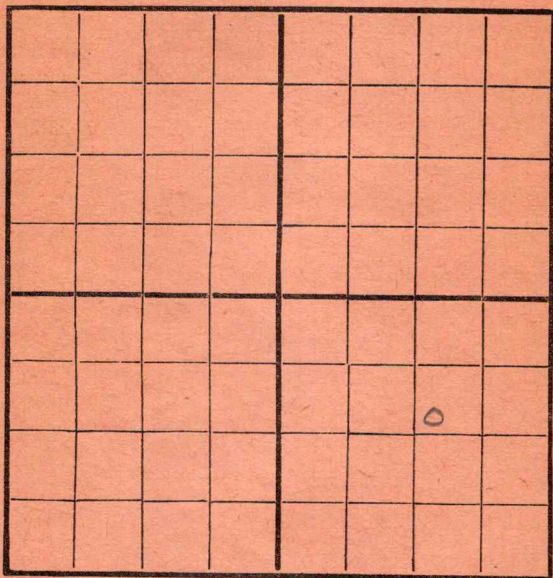

SOUTH

Location _____

Rig Up _____

Drilling and remarks

2230'

RECORD

Cased _____ in. _____ Ft.

Sand _____

Gas _____

Oil _____

Total Depth _____

PRODUCTION

1st 24 hrs. Nat. _____

1st 24 hrs. after shot _____

Gas _____ Cu. Ft.

Dry Hole _____

Abandoned _____

Date

7/12, 1916 Blount Scout

Map No. _____ Sec. 20 Twp. 28 R. 4

Well No. 11 Block Farm

Company

NORTH

WEST

EAST

SOUTH

Location _____

Rig Up -----

Drilling and remarks

2432 = On
toy of sand

RECORD

Cased _____ in. _____ Ft.

Sand.....

Gas _____

Oil _____

Total Depth

PRODUCTION

1st 24 hrs. Nat. _____

1st 24 hrs. after shot_____

Gas _____ Cu. Ft.

Dry Hole _____

Abandoned -----

Date _____


7/31, 1916 L. C. C. Scout

Map No. _____ Sec. 20 Twp. 28 R. 4Well No. 11 Bland Farm _____Company Mid Kansas

NORTH

WEST

EAST

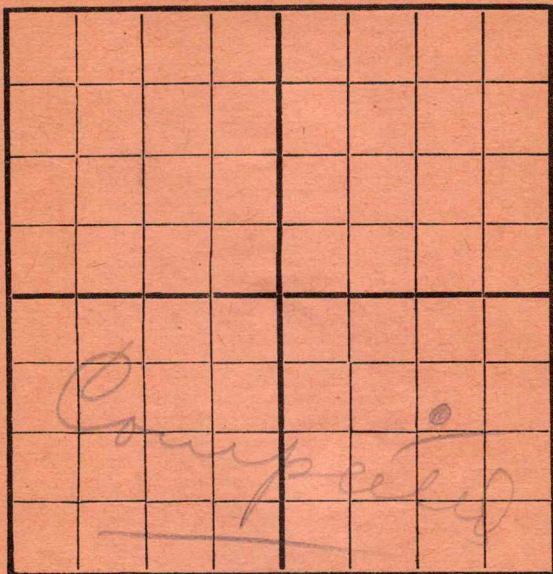

SOUTH

Location _____

Rig Up _____

Drilling and remarks _____

RECORD

Cased _____ in. _____ Ft.

Sand 2432-2457

Gas _____

Oil _____

Total Depth _____

PRODUCTION

1st 24 hrs. Nat. _____

1st 24 hrs. after shot _____

Gas _____ Cu. Ft.

Dry Hole _____

Abandoned _____

Date

7/25, 1916 B. Bland Scout

Is this in the correct
section, No. 11 on the
Blood farm is in S.W. $\frac{1}{4}$
section 21-28-4 as
shown by our map.

Miller

