


Section 31 Township 34 Range 3 E

Well No. W 1 Simeon

Company McNeish & Gralapp

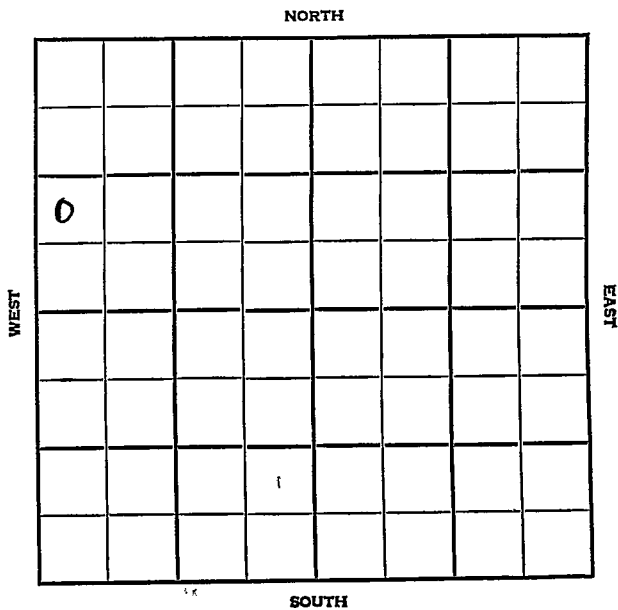

Cowley

Kansas

SEC.	TWP.	R.
31	34	3E

WELL NO. #1 Simeon FARM

COMPANY McNeish & Gralapp

CONTRACTOR Watson Drlg.


Hilltop Pool

\_\_\_\_\_ Ft. from N. Line

990 \_\_\_\_\_ Ft. from S. Line

\_\_\_\_\_ Ft. from E. Line

330 \_\_\_\_\_ Ft. from W. Line

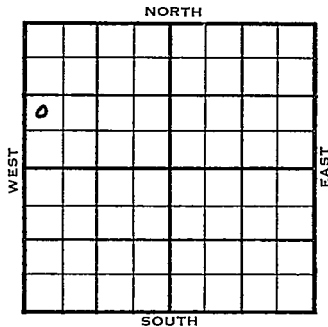

NW SW NW

1954	ELEVATION	REPORT
	1208'	

12/22 M I R

1955

1/26

Spud 12-27-54 Oil well TD 3521  
 8" @ 97 KC 2982 Oswego 3172  
 Bart. 3474 TD 3521 5" @ 3521  
 CO to 3506 42/3493-3503 SSO 2 BWPH  
 PB 3490 84/3474-88 S/5 BO 5 BW  
 24 hrs. frac. P/70 BOPD 10 BW  
 Comp. 25 BOPD

**COMPLETED**

County **Cowley** State **Kansas**

Sec. **31** (Blk. Twp.) **34** (Sur. Rge.) **3E** Map No.

Operator **McNeish & Gralapp**

Well No. **1** Farm **Simeon**

Elev. Location **NW SW NW**


FIRST REPORT

**990** Ft. From **S** Line **NW**

**330** Ft. From **W** Line Quarter

Ist. Report **DEC 22 1951**

Completion

Remarks

**Watson Drlg. - Contr.**

Spudding Date

Drlg. Data **Hilltop Pool**

**M I R**

**FABEN GILSTRAP**

County Cowley State Kansas

Sec. 31 (Bk.) 34 (Sur.) 3E Map No.

Operator McNeish & Gralapp

Well No. 1 Farm Simeon

Elev. 1208 Location NW SW NW


990 Ft. From S Line NW

330 Ft. From W Line Quarter

1st. Report

Completion JAN 26 1955

Remarks Hilltop Pool

Watson Drlg. - Contr.

Spudding Date 12-27-54

Drlg. Data Oil well TD 3521

8" @ 97 KC 2982 Oswego 3172

Bart. 3474 TD 3521 5" @ 3521 CO to

3506 42/ 3493-3503 SS0 2 bwph

PB 3490 84/ 3474-88 S/ 5 bo 5 bw

24 hr. frac P/ 70 bopd 10 bw

Comp. 25 bopd

COMPLETE

FABEN GILSTRAP