


Map No. _____ Sec 20 Twp 28 R 4Well No. 16-Blood Farm _____Ohio Company _____

NORTH

WEST

EAST

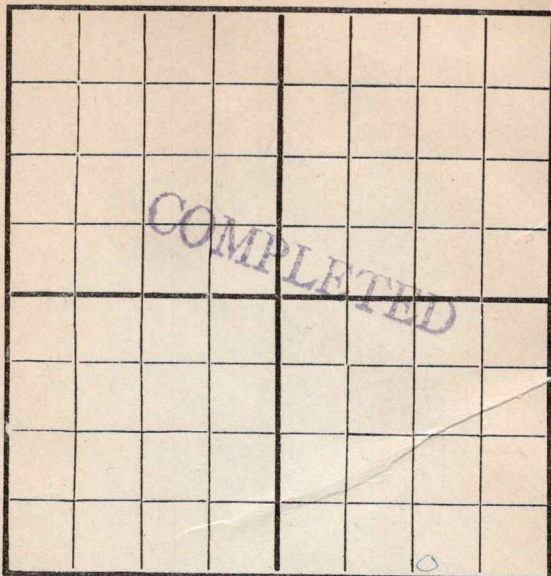

SOUTH

Location _____

Rig Up 11-14-16

Drilling Remarks:

Drilling Remarks:

R 26-11/21-11/27-12/4-12/11-12/18-180' = 12/281000 = 1/8/171840 = 1/10-

RECORD

Cased _____ in _____ Ft.

Sand _____

Gas _____

Oil _____

Total Depth _____

PRODUCTION

1st 24 hrs. Nat. _____

1st 24 hrs. after shot _____

Gas _____ Cu. Ft.

Dry Hole _____

Abandoned _____

Map No. _____ Sec. 20 Twp. 28 R. 4Well No. 16 B. L. 1 Farm _____

Company _____

NORTH

WEST

EAST

SOUTH

RECORD

Location _____

Rig Up ☒

Drilling and remarks _____

Cased _____ in. _____ Ft.

Sand _____

Gas _____

Oil _____

Total Depth _____

PRODUCTION

1st 24 hrs. Nat. _____

1st 24 hrs. after shot _____

Gas _____ Cu. Ft.

Dry Hole _____

Abandoned _____

Date

10/11, 1916, 6 Cardiff Scout

Map No. _____ Sec. 20 Twp. 28 R. 4
 Well No. 16 Blue Farm _____
Blue Company _____

NORTH

WEST

EAST

SOUTH

Location _____
 Rig Up _____
 Drilling and remarks _____

RECORD

Cased _____ in. _____ Ft.
 Sand _____
 Gas _____
 Oil _____
 Total Depth _____

PRODUCTION

1st 24 hrs. Nat. _____
 First 24 hrs. after shot _____
 Gas _____ Cu. Ft.
 Dry Hole _____
 Abandoned _____

Date

11/14, 1916 Conley Scout


Map No. _____ Sec. 20 Twp. 28 R. 4Well No. 1613 Farm _____

_____ Company _____

NORTH

WEST

EAST

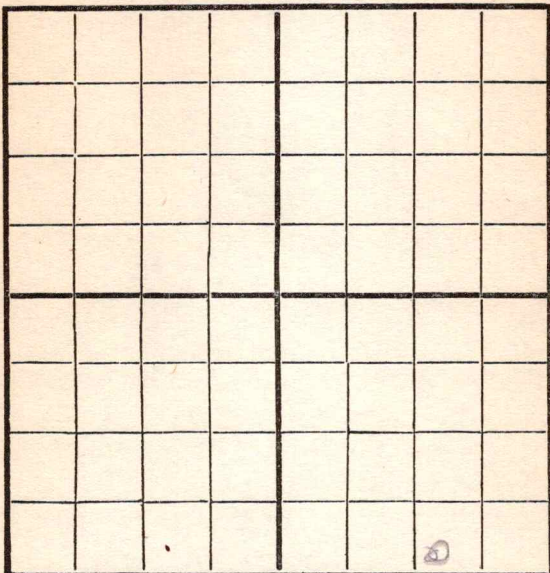

SOUTH

Location _____

Rig Up ☒ _____

Drilling and remarks _____

RECORD

Cased _____ in. _____ Ft.

Sand _____

Gas _____

Oil _____

Total Depth _____

PRODUCTION

1st 24 hrs. Nat. _____

1st 24 hrs. after shot _____

Gas _____ Cu. Ft.

Dry Hole _____

Abandoned _____

Date


11/20/1916 Scout P. R. R. R.

Map No. _____ Sec. 20 Twp. 28 R. 4
 Well No. 16 Blevins Farm _____
Ohio Company _____

NORTH

WEST

EAST

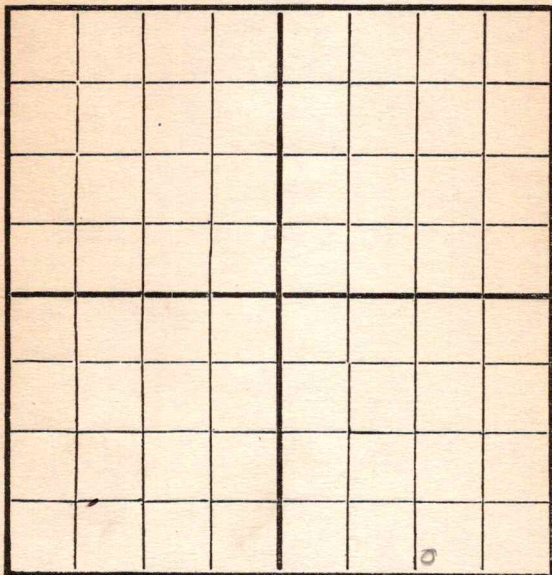

SOUTH

Location _____
 Rig Up ☒ _____
 Drilling and remarks _____

RECORD

Cased _____ in. _____ Ft.
 Sand _____
 Gas _____
 Oil _____
 Total Depth _____

PRODUCTION

1st 24 hrs. Nat. _____
 1st 24 hrs. after shot _____
 Gas _____ Cu. Ft.
 Dry Hole _____
 Abandoned _____


Date

1/27, 1916 C. C. C. Co. Scout

Map No. _____ Sec. 20 Twp. 28 R. 4Well No. 16 Blood Farm _____Ohio Company _____

NORTH

WEST

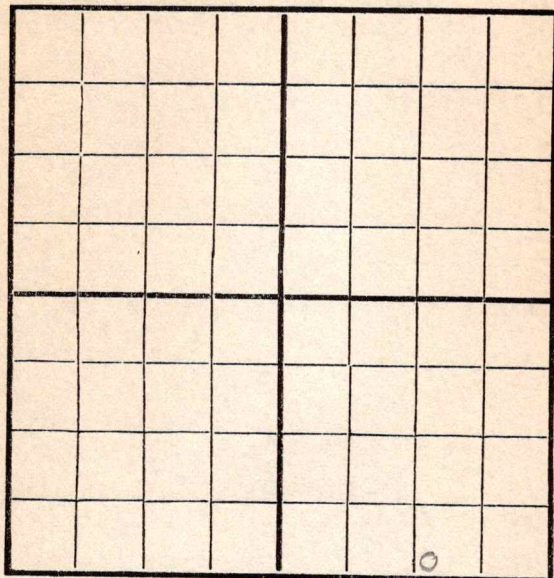

EAST

SOUTH

Location _____

Rig Up ☒ _____

Drilling and remarks _____

RECORD

Cased _____ in. _____ Ft.

Sand _____

Gas _____

Oil _____

Total Depth _____

PRODUCTION

1st 24 hrs. Nat. _____

1st 24 hrs. after shot _____

Gas _____ Cu. Ft.

Dry Hole _____

Abandoned _____

Date


12/4, 1916, Cordy Scout

Map No. _____ Sec. 20 Twp. 28 R. 4

Well No. 16 Blood Farm _____

Oliver Company _____

NORTH

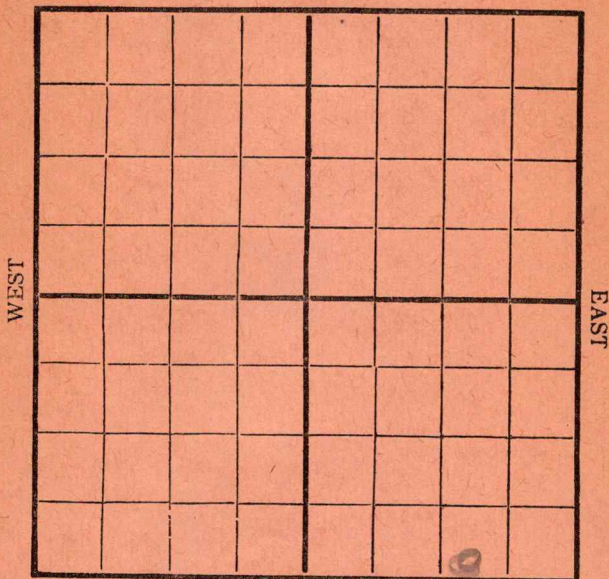

SOUTH

Location ✓

Rig Up ✓

Drilling and remarks

RECORD

Cased _____ in. _____ Ft.

Sand _____

Gas _____

Oil _____

Total Depth _____

PRODUCTION

1st 24 hrs. Nat. _____

1st 24 hrs. after shot _____

Gas _____ Cu. Ft.

Dry Hole _____

Abandoned _____


Date

12/18, 1916 C. C. C. Scout

Map No. _____ Sec. 20 Twp. 28 R. 4
 Well No. 16 Bloop Farm _____
Ohio Company _____

NORTH

WEST

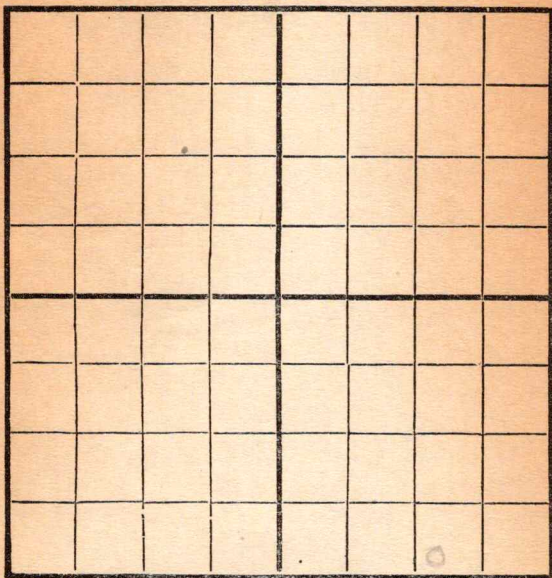

EAST

SOUTH

Location _____
 Rig Up _____
 Drilling and remarks _____

RECORD

Cased _____ in. _____ Ft.
 Sand _____
 Gas _____
 Oil _____
 Total Depth _____

PRODUCTION

1st 24 hrs. Nat. _____
 First 24 hrs. after shot _____
 Gas _____ Cu. Ft.
 Dry Hole _____
 Abandoned _____


Date

12 Feb 6 1916 Conley Scout

Map No. _____ Sec. 20 Twp. 28 R. 4
 Well No. 16 Blaine Farm _____
 _____ Company

NORTH

WEST

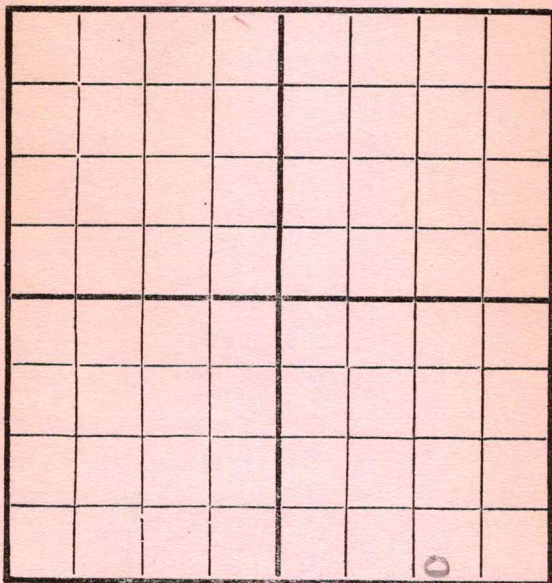

EAST

SOUTH

Location _____
 Rig Up _____
 Drilling and remarks

885

RECORD

Cased _____ in. _____ Ft.
 Sand _____
 Gas _____
 Oil _____
 Total Depth _____

PRODUCTION

1st 24 hrs. Nat. _____
 First 24 hrs. after shot _____
 Gas _____ Cu. Ft.
 Dry Hole _____
 Abandoned _____

Date

7/1, 191 7 Early Scout

Map No. _____ Sec. _____ Twp. _____ R. _____
Well No. 16 13 land _____ Farm
_____ Ohio _____ Company

NORTH

WEST

EAST

SOUTH

Location _____
Rig Up _____
Drilling and remarks _____

RECORD

Cased _____ in. _____ Ft.
 Sand _____
 Gas _____
 Oil _____
 Total Depth _____

PRODUCTION

1st 24 hrs. Nat. _____
1st 24 hrs. after shot _____
Gas _____ Cu. Ft. _____
Dry Hole _____
Abandoned _____


Date _____

191 Scout

Map No. _____ Sec. 20 Twp. 28 R. 4
 Well No. 16 Blount Farm _____
Oliver Company _____

NORTH

WEST

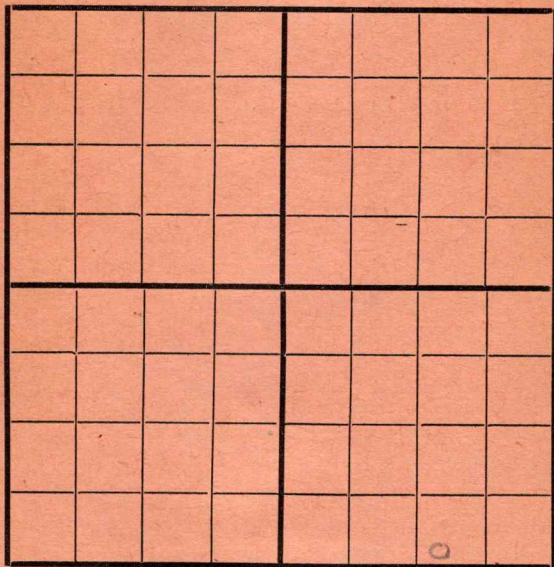

EAST

SOUTH

Location _____

Rig Up _____

Drilling and remarks

1840

RECORD

Cased _____ in. _____ Ft.

Sand _____

Gas _____

Oil _____

Total Depth _____

PRODUCTION

1st 24 hrs. Nat. _____

1st 24 hrs. after shot _____

Gas _____ Cu. Ft.

Dry Hole _____


Abandoned _____

Date

1/15, 1917 Co. 1st Scout

Map No. _____ Sec. 20 Twp. 28 R. 4
 Well No. 16 Bloom Farm _____
Ohio Company _____

NORTH

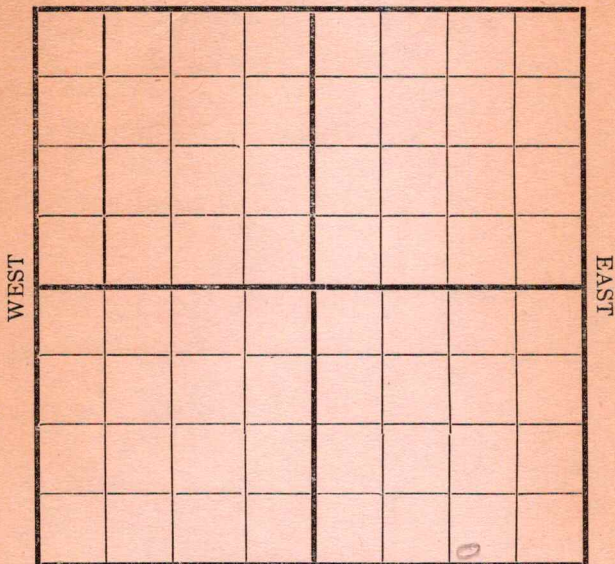

SOUTH

Location _____

Rig Up _____

Drilling and remarks

2200

RECORD

Cased _____ in. _____ Ft.

Sand _____

Gas _____

Oil _____

Total Depth _____

PRODUCTION

1st 24 hrs. Nat. _____

1st 24 hrs. after shot _____

Gas _____ Cu. Ft.

Dry Hole _____

Abandoned _____

Date


1/22, 1912 Early Scout

120. 1912. _____ Scout

Map No. _____ Sec. 20 Twp. 28 R. 4
 Well No. 1613000 Farm _____
Ohio Company _____

NORTH

WEST

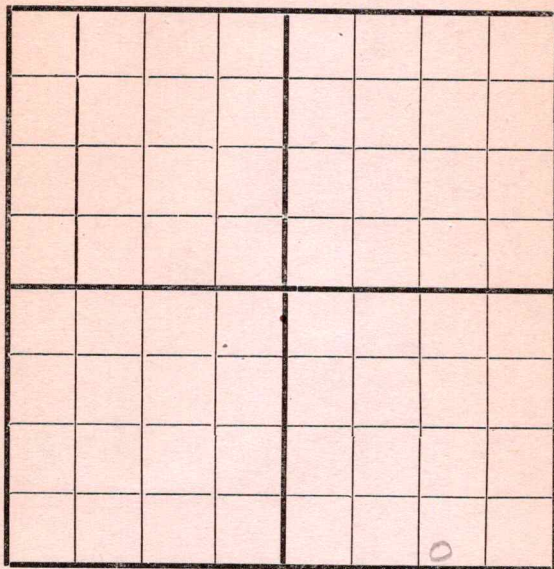

EAST

SOUTH

Location _____

Rig Up _____

Drilling and remarks

Under-
Running
2415

RECORD

Cased _____ in. _____ Ft.

Sand _____

Gas _____

Oil _____

Total Depth _____

PRODUCTION

1st 24 hrs. Nat. _____

1st 24 hrs. after shot _____

Gas _____ Cu. Ft.

Dry Hole _____

Abandoned _____

Date


75, 191 7 Emery Scout

Map No. _____ Sec. 20 Twp. 28 R. 4
 Well No. 16 Blood Farm _____
Ohio Company _____

NORTH

WEST

EAST

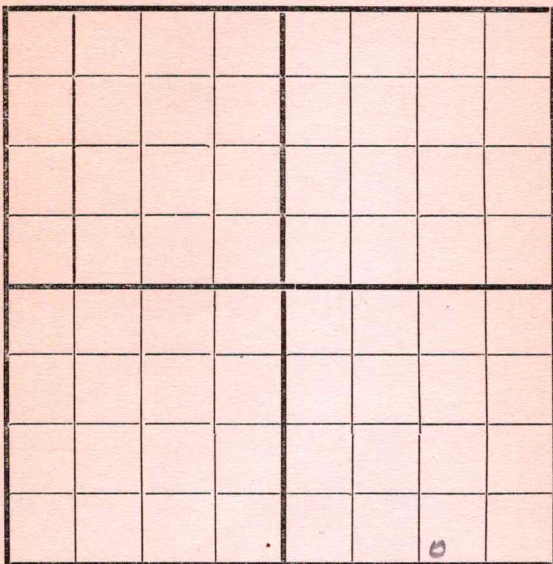

SOUTH

Location _____
 Rig Up _____
 Drilling and remarks _____

*Under
 Running
 2415*

RECORD

Cased _____ in. _____ Ft.
 Sand _____
 Gas _____
 Oil _____
 Total Depth _____

PRODUCTION


1st 24 hrs. Nat. _____
 1st 24 hrs. after shot _____
 Gas _____ Cu. Ft.
 Dry Hole _____
 Abandoned _____

Date Feb 7 1917 *Carley* Scout _____

Map No. _____ Sec. 20 Twp. 28 R. 4
 Well No. 16 Blount Farm _____
Oliver Company _____

NORTH

WEST

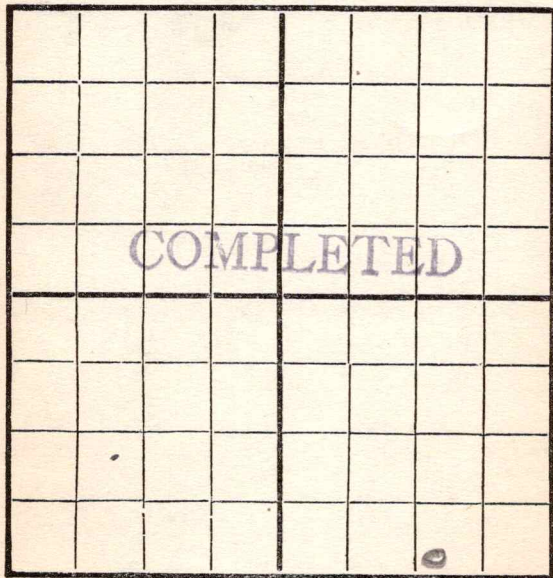

EAST

SOUTH

Location _____

Rig Up _____

Drilling and remarks

Est at
200 Bbs

RECORD

Cased _____ in. _____ Ft.

Sand 2455-2502

Gas _____

Oil _____

Total Depth _____

PRODUCTION

1st 24 hrs. Nat. _____

First 24 hrs. after shot _____

Gas _____ Cu. Ft.

Dry Hole _____

Abandoned _____

Date


2/19, 1917 200 Bbs Scout

Map No. _____ Sec. 20 Twp. 28 R. 4
 Well No. 16 Bloom Farm _____
Ohio Company _____

NORTH

WEST

EAST

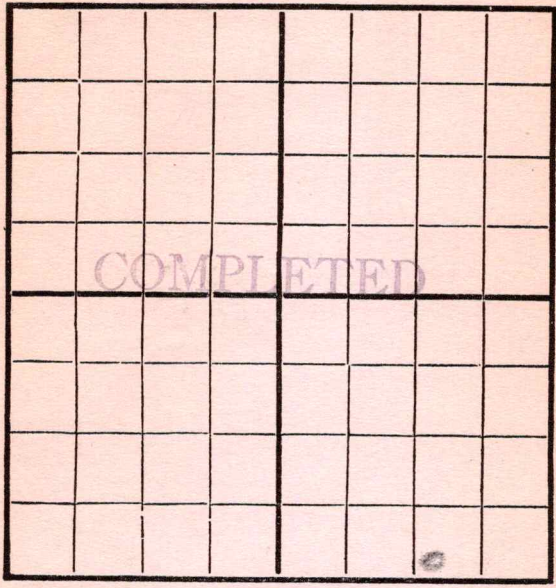

SOUTH

Location _____

Rig Up _____

Drilling and remarks

Est at
200 Bbs

RECORD

Cased _____ in. _____ Ft.

Sand 2455-2502

Gas _____

Oil _____

Total Depth _____

PRODUCTION

1st 24 hrs. Nat. _____

First 24 hrs. after shot _____

Gas _____ Cu. Ft.

Dry Hole _____

Abandoned _____

Date

2/19, 1917 2 Scout