


Map No. _____ Sec. 20 Twp. 28 R. K

Well No. 20 Blood Farm _____
Ohio Company _____

NORTH

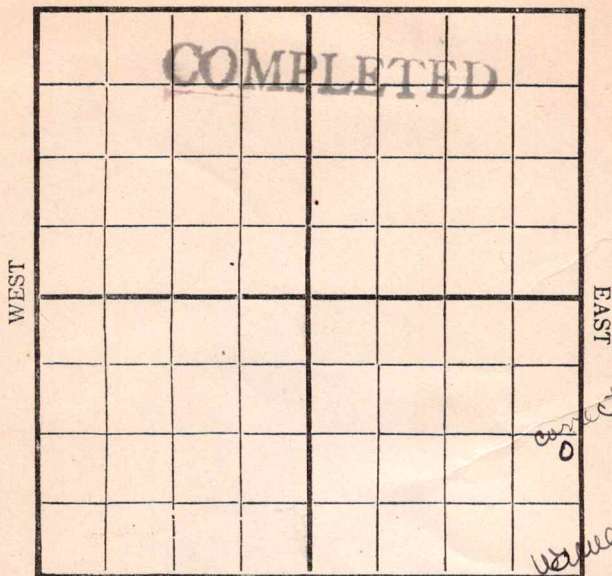

SOUTH

Location _____

Rig Up _____

Drilling Remarks:

Drilling Remarks:

RECORD

PRODUCTION

Cased _____ in _____ Ft.

1st 24 hrs. Nat. _____

S and _____

1st 24 hrs. after shot _____

Gas _____

Gas _____ Cu. Ft.

Oil _____

Dry Hole _____

Total Depth _____

Abandoned _____

Map No. K11 Sec. 20 Twp. 28 R. 4Well No. 20 Bloop Farm

Company

NORTH

WEST

EAST

SOUTH

Location

Rig Up

Drilling and remarks

RECORD

Cased in. Ft.

Sand

Gas

Oil

Total Depth

PRODUCTION

1st 24 hrs. Nat.

First 24 hrs. after shot

Gas Cu. Ft.

Dry Hole

Abandoned

Date

191

Scout

Map No. _____ Sec. 20 Twp. 28 R. 4
Well No. 20 Blue _____ Farm
Ohio _____ Company

NORTH

WEST

EAST

SOUTH

Location _____
Rig Up _____
Drilling and remarks _____

FIRST REPORT

RECORD

Cased _____ in. _____ Ft.
 Sand _____
 Gas _____
 Oil _____
 Total Depth _____

PRODUCTION


1st 24 hrs. Nat.
1st 24 hrs. after shot.....
Gas..... Cu. Ft.
Dry Hole.....
Abandoned.....

Date _____

2521, 1917. *Carroll* Scout

Map No. K11 Sec. 20 Twp. 28 R. 4
 Well No. 20 Bloop Farm _____
Oliver Company _____

NORTH

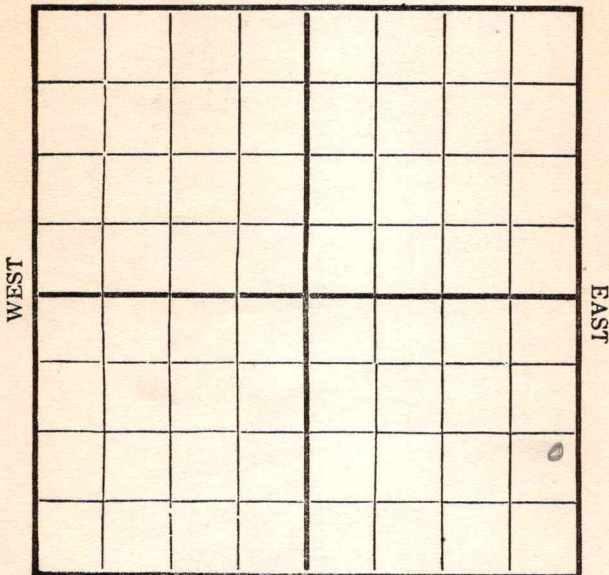

SOUTH

Location _____
 Rig Up ☒ _____
 Drilling and remarks _____

RECORD

Cased _____ in. _____ Ft.
 Sand _____
 Gas _____
 Oil _____
 Total Depth _____


PRODUCTION

1st 24 hrs. Nat. _____
 First 24 hrs. after shot _____
 Gas _____ Cu. Ft.
 Dry Hole _____
 Abandoned _____

Date 7/26 1912 C. A. D. S. Scout ☒

Map No. _____ Sec. 30 Twp. 28 R. 4
Well No. 20 Bloss Farm _____
Ohio Company _____

NORTH

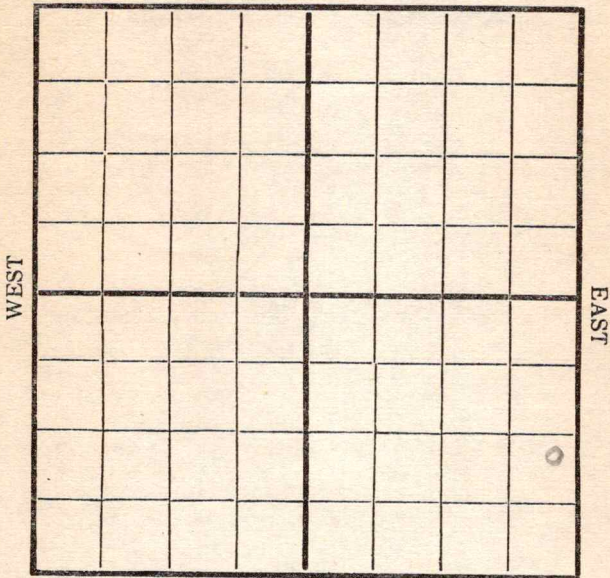

SOUTH

REMARKS:


708'

Date

3/5, 1917 Cordif Scout

Map No. _____ Sec. 20 Twp. 28 R. 4
Well No. 20 Blount Farm _____
Ohio Company _____

NORTH

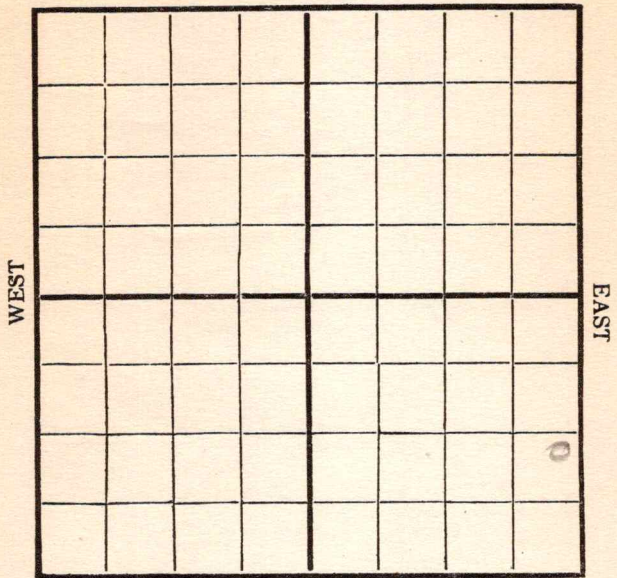

SOUTH

Location _____
Rig Up _____
Drilling and remarks _____

Shut Down
700'

RECORD

Cased _____ in. _____ Ft.
Sand _____
Gas _____
Oil _____
Total Depth _____

PRODUCTION

1st 24 hrs. Nat. _____
1st 24 hrs. after shot _____
Gas _____ Cu. Ft.
Dry Hole _____
Abandoned _____

Date 3/12 1912 C. C. C. Scout

Map No. _____ Sec. 20 Twp. 28 R. 4Well No. 20 Bland Farm __________ Ohio Company _____

NORTH

WEST

EAST

SOUTH

Location _____

Rig Up _____

Drilling and remarks
1578'

RECORD

Cased _____ in. _____ Ft.

Sand _____

Gas _____

Oil _____

Total Depth _____

PRODUCTION

1st 24 hrs. Nat. _____

1st 24 hrs. after shot _____

Gas _____ Cu. Ft.

Dry Hole _____

Abandoned _____

Date

3/19, 191 7 Carleiff Scout

Map No. _____ Sec. 20 Twp. 28 R. 4
 Well No. 20 Bump Farm _____
Oleio Company _____

NORTH

WEST

EAST

SOUTH

Location _____
 Rig Up _____
 Drilling and remarks

1620

RECORD

Cased _____ in. _____ Ft.
 Sand _____
 Gas _____
 Oil _____
 Total Depth _____


PRODUCTION

1st 24 hrs. Nat. _____
 1st 24 hrs. after shot _____
 Gas _____ Cu. Ft.
 Dry Hole _____
 Abandoned _____

Date 3/26, 1917 Scout _____

Map No. _____ Sec. 20 Twp. 28 R. 4
 Well No. 20 Blend Farm _____
Oliver Company _____

NORTH

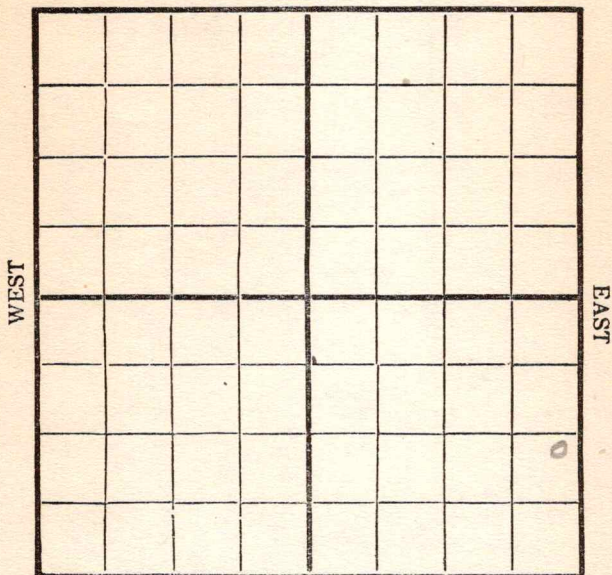

SOUTH

Location _____
 Rig Up _____
 Drilling and remarks _____

2150'

RECORD

Cased _____ in. _____ Ft.
 Sand _____
 Gas _____
 Oil _____
 Total Depth _____

PRODUCTION


1st 24 hrs. Nat. _____
 First 24 hrs. after shot _____
 Gas _____ Cu. Ft.
 Dry Hole _____
 Abandoned _____

Date

4/4, 1917 C. Conley Scout

Map No. _____ Sec. 20 Twp. 28 R. 4
 Well No. 20 Blend Farm _____
Oliver Company _____

NORTH

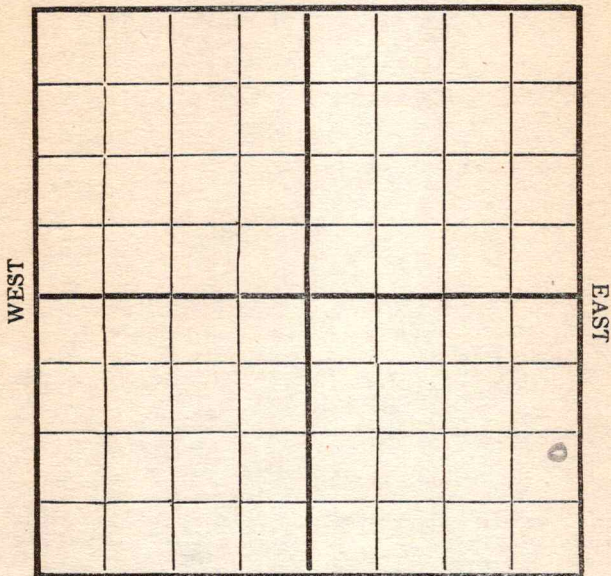

SOUTH

Location _____
 Rig Up _____
 Drilling and remarks

2460'

RECORD

Cased _____ in. _____ Ft.
 Sand _____
 Gas _____
 Oil _____
 Total Depth _____

PRODUCTION

1st 24 hrs. Nat. _____
 1st 24 hrs. after shot _____
 Gas _____ Cu. Ft.
 Dry Hole _____
 Abandoned _____

Date 7/10, 1917 Curry Scout

Map No. _____ Sec. 20 Twp. 28 R. 4
Well No. 20 Blood Farm _____
Ohio Company _____

NORTH



SOUTH

Location _____
Rig Up _____
Drilling and remarks

*Estimated
good for
150
Bbls*

RECORD

Cased _____ in. _____ Ft.
Sand 2465-2518
Gas _____
Oil _____
Total Depth _____

PRODUCTION

1st 24 hrs. Nat. _____
1st 24 hrs. after shot _____
Gas _____ Cu. Ft.
Dry Hole _____
Abandoned _____

Date 4/17, 191 7 Cond Scout