


Section 32 Township 34 Range 3E

Well No. #1 Baird

Company Aladdin Pet.

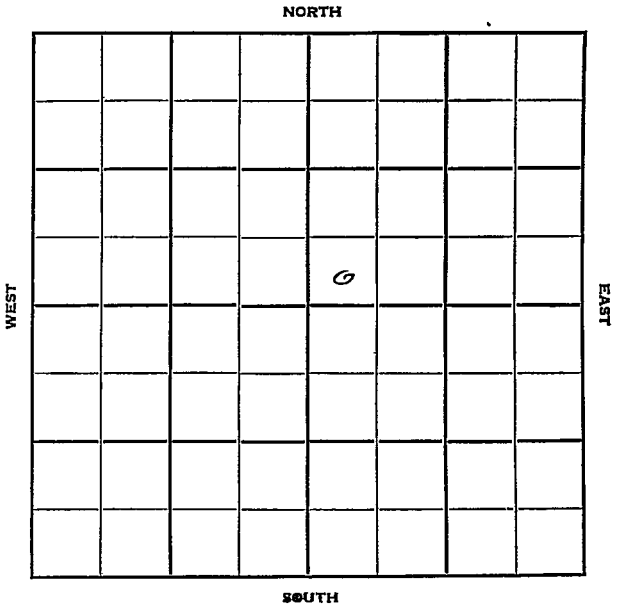

Cowley

KANSAS

Sec. 32 Twp. 34 R. 3E

Well No. #1 Baird Farm

Aladdin Petroleum Company

Martin & Cash - Contr. Contractor
S. Gibson Pool


Ft. from N. Line

330' Ft. from S. Line

Ft. from E. Line

330' Ft. from W. Line

SW SW NE

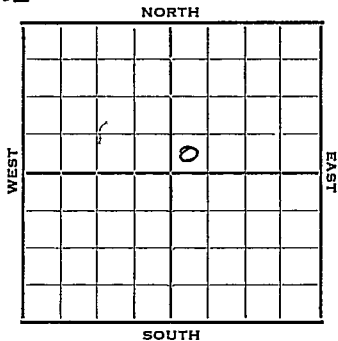

1952

Elev. 1134' REPORT

3/19

Spud 3-10-52

8" @ 125

DST 1432-50 opn $\frac{1}{2}$ hr. r c 2,900,000
gas Blew out Fishing tester

4/9

Spud 3-10-52

Gas Well TD 1500

8" @ 125

DST 1432-50 opn $\frac{1}{2}$ hr.

Rec. 2,900,000 gas TD 1500

5" @ 1498 18/1432-38 3 to 4

M gas Comp. 14,234,000 gas

COMPLETED

