

Cowley

Sec. 32 Twp. 3 4 R. 3E

Well No. #2 Baird-Brennon Farm

Aladdin Pet. Company

Paul Septer Contractor


_____ Ft. from N. Line

430 Ft. from S. Line

_____ Ft. from E. Line

355 Ft. from W. Line

SW SW NE (Twin)

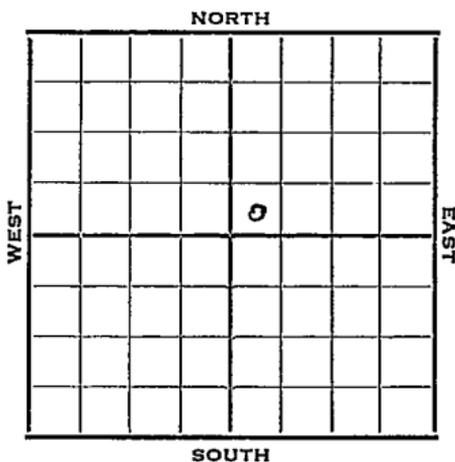

1952

Elev. 1136'

REPORT

4/22

Spud 4-18-52
10" @ 125'
Drlg. 790'

6/4

Spud 4-18-52
Oil Well TD 3414
10" @ 125' Bart. 3355 Miss. 3389'
TD 3414 5" @ 3413 DO 3381
30/ 3369-76 Stratofrac F/ 20 boph
Comp. 379 bopd

COMPLETED

