


Section 32 Township 31 Range 3 E

Well No. # 3 Baird - Drennan

Company Alladdin

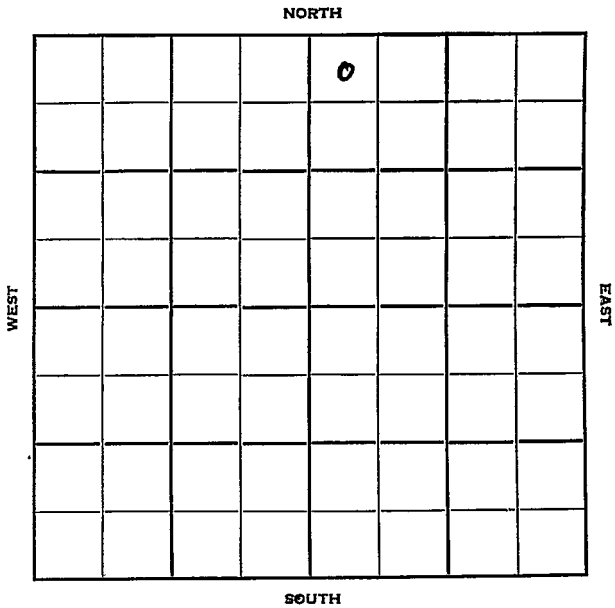

Sec. 32 Twp. 34 R. 3E

Well No. #3 Baird- Drennan Farm

Aladdin Company

Crow Contractor


330 Ft. from N. Line

Ft. from S. Line

Ft. from E. Line

330 Ft. from W. Line

NW NW NE (Twin)

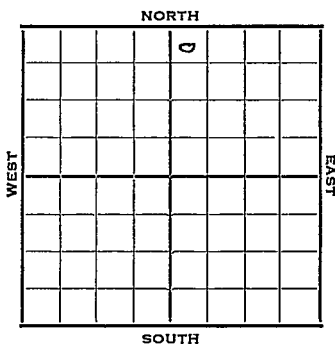

1952

Elev. 1145 REPORT

6/11 Location

7/16 Spud 6-10-52
Oil Well TD 3413
Bart 3363 GO to 3413 Hydro.
F/30 boph F/20 boph
Comp. BHB 3000 bopd

COMPLETED

County Cowley State Kansas

Sec. 32 (Blk. Twp.) 34 (Sur. Rge.) 3E Map No.

Operator Aladdin

Well No. 3 Farm Baird - Drennan

Elev. _____ Location NW NW NE (twin)

FIRST REPORT

330 Ft. From N Line NE

330 Ft. From W Line Quarter

1st. Report JUN 11 1952

Completion _____

Remarks _____

Grow - Contr.

Spudding Date _____

Drig. Data _____

Location

J. G. McGEHEE

