


Section 32 Township 34 Range 3E

Well No. #5 Baird-Drennen

Company Aladdin Pet.

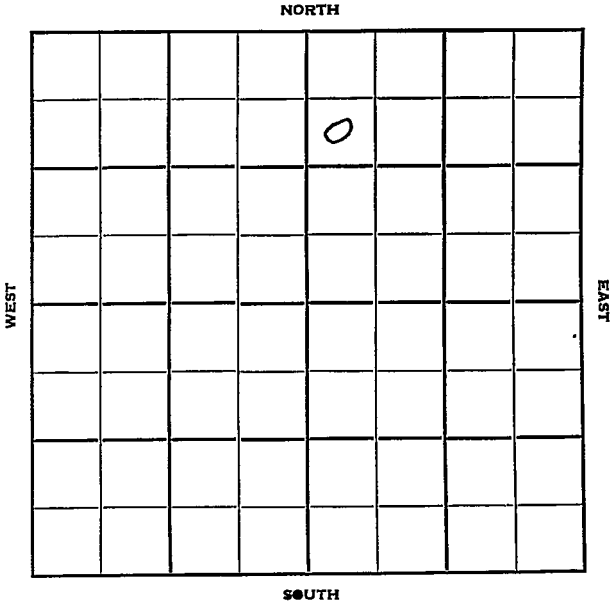

Cowley

KANSAS ✓

Sec. 32 Twp. 34 R. 3E

Well No. #5 Baird-Drennen Farm

Aladdin Pet. Company

Gibson S Contractor


990' Ft. from N. Line

_____ Ft. from S. Line

_____ Ft. from E. Line

330' Ft. from W. Line

SW NW NE

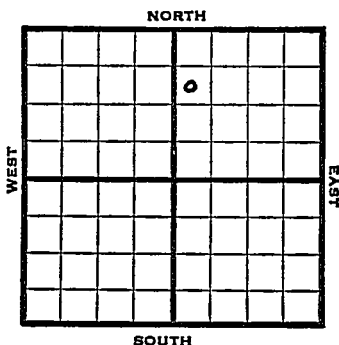

1952

Elev. 1135 REPORT

7/2

Location

8/6

Spud 7-5-52

Oil Well TD 3392

8" @ 145 Bart 3359

5" @ 3360 CO to 3392

F/1 1/2 boph Hydro

F/19 1/2 boph Comp. BHB 2463 bopd

COMPLETED

