


Section 32 Township 34 Range 3E

Well No. #8 Baird-Drennan

Company Aladdin Petroleum

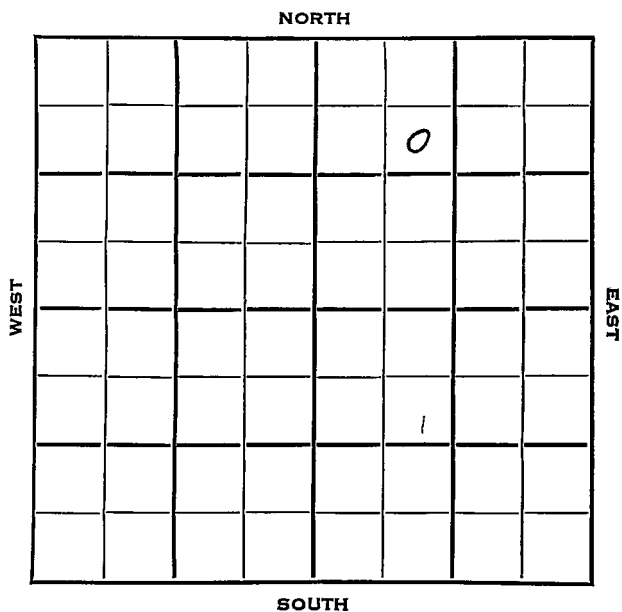

Sec. 32 Twp. 34 R. 3E

Well No. #8 Baird-Drennan Farm

Aladdin Petroleum Company

Crowe Drlg. Contractor


Baird Pool

990 Ft. from N. Line

\_\_\_\_\_ Ft. from S. Line

\_\_\_\_\_ Ft. from E. Line

990 Ft. from W. Line

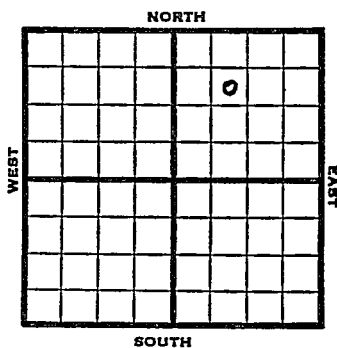

SE NW NE

1953

Elev. 1129' REPORT

8/19

Location

10/7

Spud 8-23-53  
 Oil Well  
 TD 3393'  
 8" @ 128'  
 Bart 3377'  
 TD 3393'  
 5" @ 3360'  
 CO to 3380 Hydro.  
 PB 3375 CO to 3380 Hydro.  
 F/ 50 boph  
 Comp 1050 bopd.

**COMPLETED**



