

WEST

EAST

SOUTH

Location -----

Drilling Remarks:

Rig Up -----

Drilling Remarks:

RECORD

Cased----- in.----- ft.

Sand _____

Gas -----

Oil_____

Total Depth -----

PRODUCTION

1st 24 hrs. Nat.-----

1st 24 hrs. after shot-----

Gas cu. ft

Dry Hole -----

Abandoned -----

Map No. 511 Sec. 20 Twp. 28 R. 4

Well No. 17 Haskins

Empire Company

Contractor

NORTH

WEST

EAST

		0					

SOUTH

330X990E

Location _____

Rig up ☒

Drilling and Remarks:

RECORD

Cased _____ in., _____ ft.

Sand _____

Gas _____

Oil _____

Total Depth _____

PRODUCTION

1st 24 hrs. Nat. _____

1st 24 hrs. after shot _____

Gas _____ Cu. Ft.

Dry Hole _____

Abandoned _____

FIRST REPORT

Date

11/14

191

8 Coady

Scout


Map No. 1511 Sec. 20 Twp. 28 R. 4Well No. 17 HoskinsEngine Company

Contractor

NORTH

WEST

EAST

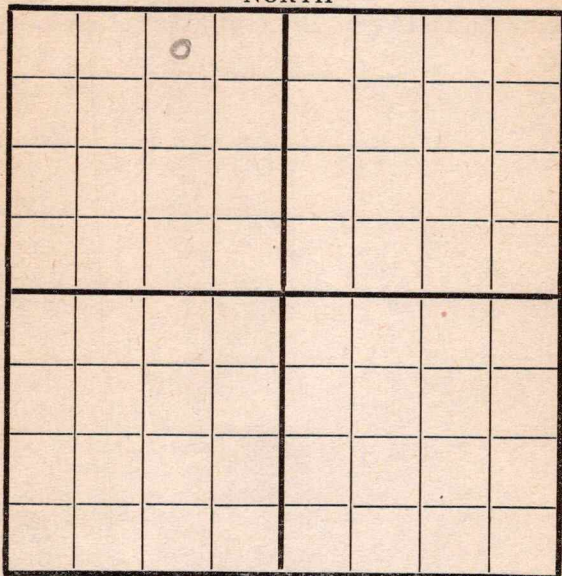

SOUTH

330 X 990 E

Location _____

Rig up ☒ _____

Drilling and Remarks:

RECORD

Cased _____ in., _____ ft.

Sand _____

Gas _____

Oil _____

Total Depth _____

PRODUCTION

1st 24 hrs. Nat. _____

1st 24 hrs. after shot _____

Gas _____ Cu. Ft.

Dry Hole _____

Abandoned _____

Date

11/20 1918 S. Carley Scout

Map No. 1511 Sec. 20 Twp. 28 R. 4Well No. 17 39 0 12 1/2Company Engineer

Contractor _____

NORTH

WEST

EAST

		0					

SOUTH

33040990

Location _____

Rig up ☒

Drilling and Remarks:

RECORD

Cased _____ in., _____ ft.

Sand _____

Gas _____

Oil _____

Total Depth _____

PRODUCTION

1st 24 hrs. Nat. _____

1st 24 hrs. after shot _____

Gas _____ Cu. Ft.

Dry Hole _____

Abandoned _____

Date

11/27 1918 Scout

Map No. K11 Sec. 20 Twp. 28 R. 4Well No. 17 HoskinsEmpire Company

Contractor

NORTH

WEST

EAST

SOUTH

Location _____

Rig up ☒

Drilling and Remarks:

RECORD

Cased _____ in., _____ ft.

Sand _____

Gas _____

Oil _____

Total Depth _____

PRODUCTION

1st 24 hrs. Nat. _____

1st 24 hrs. after shot _____

Gas _____ Cu. Ft.

Dry Hole _____

Abandoned _____

Date

12/4 191 J. Conley Scout


Map No. K 11 Sec. 20 Twp. 28 R. 4Well No. 17140 skinCompany Engine

Contractor _____

NORTH

WEST

EAST

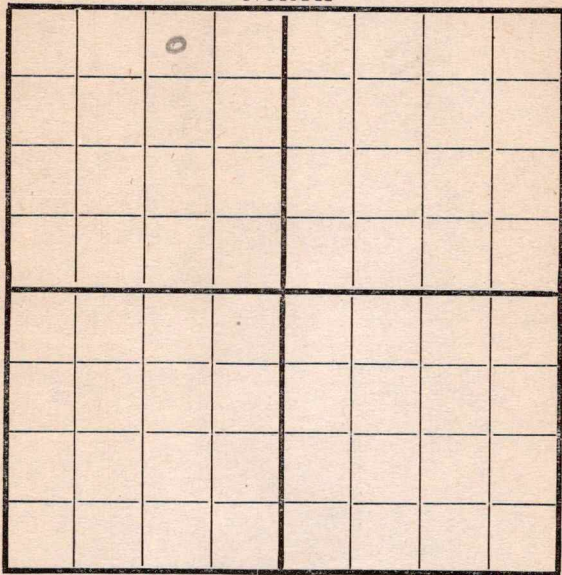

SOUTH

Location _____

Rig up ☒

Drilling and Remarks:

RECORD

Cased _____ in., _____ ft.

Sand _____

Gas _____

Oil _____

Total Depth _____

PRODUCTION

1st 24 hrs. Nat. _____

1st 24 hrs. after shot _____

Gas _____ Cu. Ft.

Dry Hole _____


Abandoned _____

Date

12/11 191 8 C. C. C. C. Scout

Map No. K 11 Sec. 20 Twp. 38 R. 4Well No. 17 HuskinsEngine CompanyBoggs Drilling Co ContractorAugusta NORTH Kans

WEST

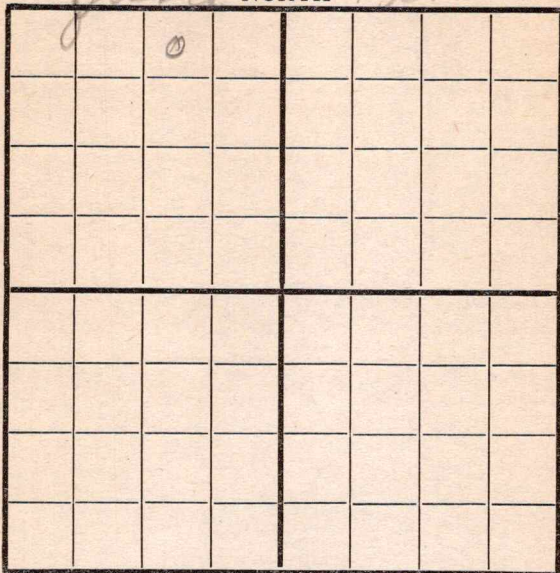

EAST

330x990 SOUTH

Location _____

Rig up _____

Drilling and Remarks:

Rigged up

RECORD

Cased _____ in., _____ ft.

Sand _____

Gas _____

Oil _____

Total Depth _____

PRODUCTION

1st 24 hrs. Nat. _____

1st 24 hrs. after shot _____

Gas _____ Cu. Ft.

Dry Hole _____

Abandoned _____

Date

12/18 J. C. Carey Scout

Map No. 1511 Sec. 20 Twp. 38 R. 4

Well No. 17 Hotchkiss


Engine Company

Contractor

NORTH

WEST

EAST

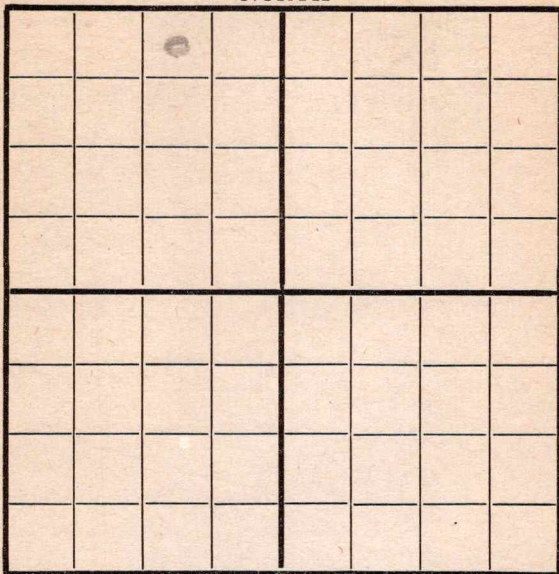

SOUTH

33 or 990

Location

Rig up

Drilling and Remarks:

Rigged up

RECORD

Cased in, ft.

Sand

Gas

Oil

Total Depth

PRODUCTION

1st 24 hrs. Nat.

1st 24 hrs. after shot

Gas Cu. Ft.

Dry Hole

Abandoned

Date

10/25 1911 S. C. C. C. Scout

Map No. 511 Sec. 20 Twp. 28 R. 4Well No. 1434000000Company Engine

Contractor _____

NORTH

WEST

EAST

SOUTH

RECORD

Location _____

Cased _____ in., _____ ft.

Rig up _____

Sand _____

Drilling and Remarks:

Gas _____

Oil _____

Total Depth _____

PRODUCTION

1st 24 hrs. Nat. _____

1st 24 hrs. after shot _____

Gas _____ Cu. Ft.

Dry Hole _____

Abandoned _____

Date 1/1


Map No. K11 Sec. 20 Twp. 28 R. 4Well No. 17 HookinsEngine Company

Contractor

NORTH

WEST

EAST

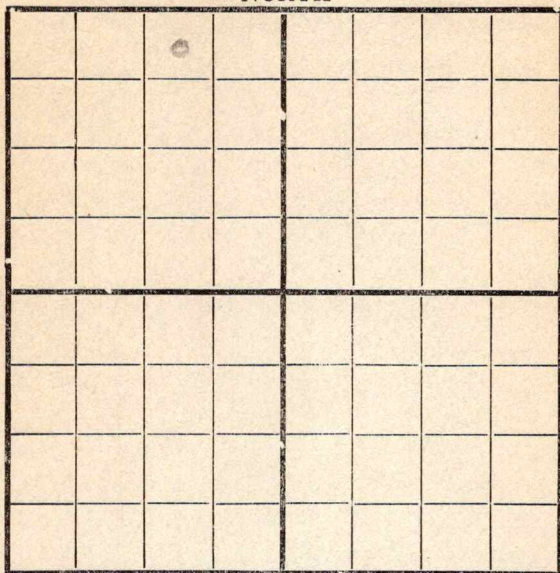

SOUTH

3308990ELocation ✓Rig up ✓

Drilling and Remarks:

RECORD

Cased.....in.,ft.

Sand.....

Gas.....

Oil.....

Total Depth.....

PRODUCTION

1st 24 hrs. Nat.

1st 24 hrs. after shot.....

Gas.....Cu. Ft.

Dry Hole.....

Abandoned.....

Date

1/8 1919 C. C. C. Scout

Map No. K 11 Sec. 20 Twp. 28 R. 4

Well No. 17 Haskins

Empire Company

Contractor

NORTH

WEST

EAST

		0					

SOUTH

330 14 9902

Location _____

Rig up ☒

Drilling and Remarks:

RECORD

Cased _____ in., _____ ft.

Sand _____

Gas _____

Oil _____

Total Depth _____

PRODUCTION

1st 24 hrs. Nat. _____

1st 24 hrs. after shot _____

Gas _____ Cu. Ft.

Dry Hole _____

Abandoned _____

Date

1/15 1919 Condy Scout

Map No. K11 Sec. 20 Twp. 28 R. 4

Well No. 17 Hastings
Engine Company

Contractor

NORTH

WEST

EAST

		0					

33089902 SOUTH

Location

Rig up

Drilling and Remarks:

Rigged up

RECORD

Cased _____ in., _____ ft.

Sand _____

Gas _____

Oil _____

Total Depth _____

PRODUCTION

1st 24 hrs. Nat. _____

1st 24 hrs. after shot _____

Gas _____ Cu. Ft.

Dry Hole _____

Abandoned _____

Date

1/22 1919 Candey Scout

Map No. K 11 Sec. 20 Twp. 28 R. 4Well No. 17 HaskinsEmpire Company

Contractor

NORTH

WEST

EAST

		0					

330 N

SOUTH

990 E

Location _____

Rig up _____

Drilling and Remarks:

16" @

1376 ft 7 in

RECORD

Cased _____ in., _____ ft.

Sand _____

Gas _____

Oil _____

Total Depth _____

PRODUCTION

1st 24 hrs. Nat. _____

1st 24 hrs. after shot _____

Gas _____ Cu. Ft.

Dry Hole _____

Abandoned _____

Date

3/8

191

9

Pyle

Scout


Map No. K11 Sec. 20 Twp. 28 R. 4Well No. 17 HaskinsEmpire Company

Contractor

NORTH

WEST

EAST

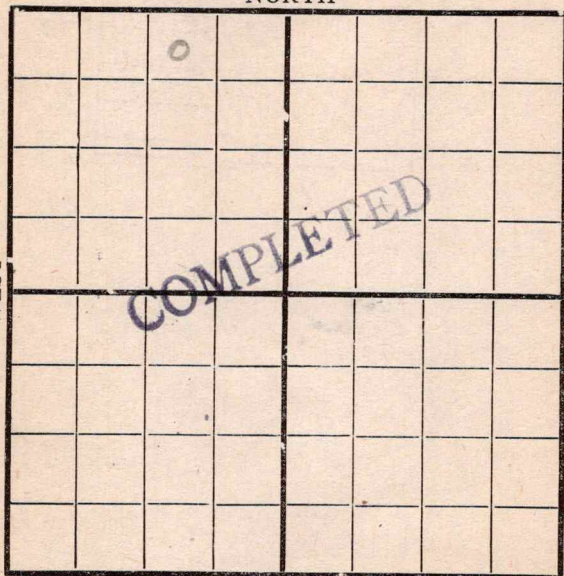

990 E

SOUTH

330 N

Location _____

Rig up _____

Drilling and Remarks:

15 bbls in
18 hrs

RECORD

Cased _____ in., _____ ft.

Sand 2481 - 2511

Gas _____

Oil _____

Total Depth _____

PRODUCTION

1st 24 hrs. Nat. _____

1st 24 hrs. after shot _____

Gas _____ Cu. Ft.

Dry Hole _____

Abandoned _____

Date

191

9

Scout