


Map No. 1002 K11 Sec. 17 Twp. 28 R. 4

Well No. 12 Hopkins Farm
Engine Company

NORTH

WEST

EAST

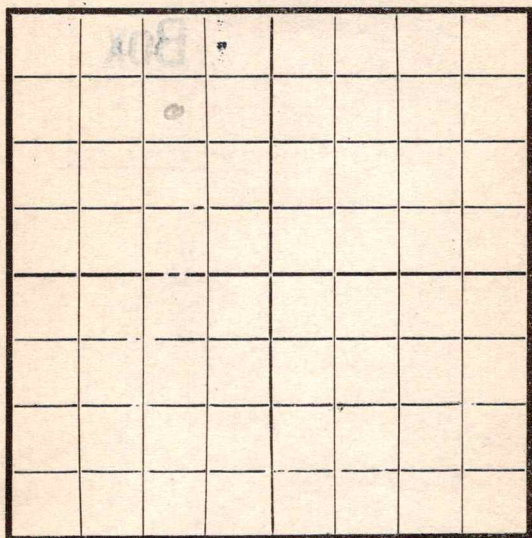

SOUTH

Location _____
 Rig Up _____
 Drilling and remarks _____

RECORD

Cased _____ in. _____ Ft.
 Sand _____
 Gas _____
 Oil _____
 Total Depth _____

FIRST REPORT

PRODUCTION

1st 24 hrs. Nat. _____
 1st 24 hrs. after shot _____
 Gas _____ Cu. Ft.
 Dry Hole _____
 Abandoned _____

Date


12/5, 1917 Conroy Scout

Map No. _____ Sec. 17 Twp. 28 R. 4Well No. 12 Hooker Farm _____

Company _____

NORTH

WEST

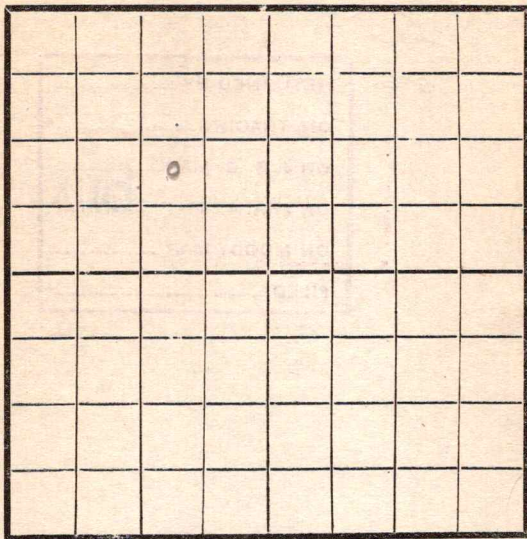

EAST

SOUTH

RECORD

Location _____ Cased _____ in _____ Ft.

Rig Up _____ Sand _____

Drilling and remarks _____ Gas _____

Oil _____

Total Depth _____

PRODUCTION

1st 24 hrs. Nat. _____

1st 24 hrs. after shot _____

Gas _____ Cu. Ft.

Dry Hole _____

Abandoned _____

Date

12/28, 1912 _____ Scout Andrew


Map No. _____ Sec. 17 Twp. 28 R. 4

Well No. 12 Hopkins Farm _____

Empire Company _____

NORTH

WEST

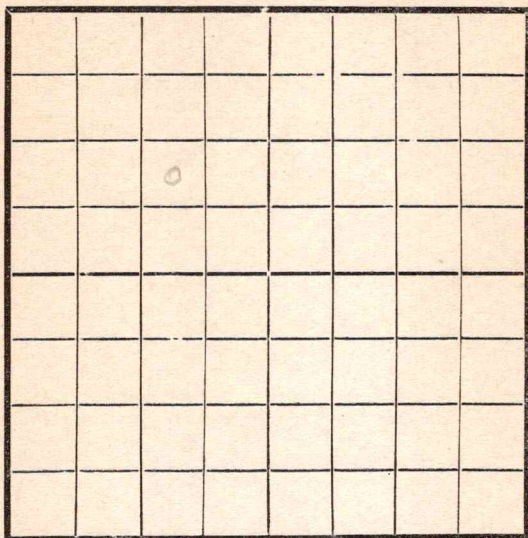

EAST

SOUTH

Location _____

Rig Up ☒ _____

Drilling and remarks _____

RECORD

Cased _____ in _____ Ft.

Sand _____

Gas _____

Oil _____

Total Depth _____

PRODUCTION

1st 24 hrs. Nat. _____

1st 24 hrs. after shot _____

Gas _____ Cu. Ft.

Dry Hole _____

Abandoned _____


Date _____

1/2, 1918 Condy Scout

Map No. _____ Sec. 17 Twp. 28 R. 4Well No. 12 Hoskins Farm _____Empire Company

NORTH

WEST

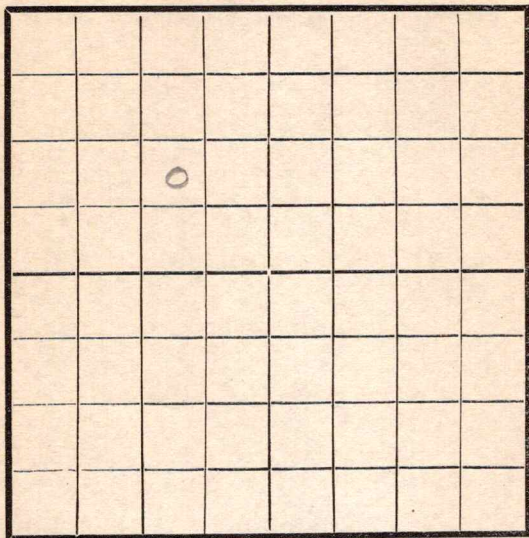

EAST

SOUTH

Location _____

Rig Up _____

Drilling and remarks

Rigged up

RECORD

Cased _____ in. _____ Ft.

Sand _____

Gas _____

Oil _____

Total Depth _____

PRODUCTION

1st 24 hrs. Nat. _____

1st 24 hrs. after shot _____

Gas _____ Cu. Ft.

Dry Hole _____

Abandoned _____


Date

1/9, 1918 S. Canby Scout

Map No. _____ Sec. 17 Twp. 28 R. 4Well No. 12 Hooker Farm
Cumprine Company

NORTH

WEST

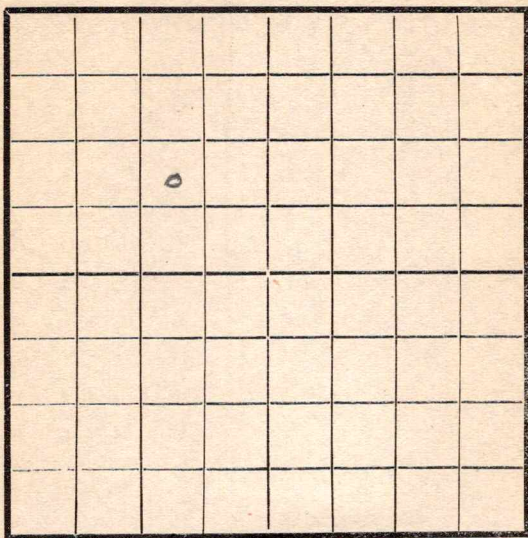

EAST

SOUTH

Location _____

Rig Up _____

Drilling and remarks

Rigged up

RECORD

Cased _____ in. _____ Ft.

Sand _____

Gas _____

Oil _____

Total Depth _____

PRODUCTION

1st 24 hrs. Nat. _____

1st 24 hrs. after shot _____

Gas _____ Cu. Ft.

Dry Hole _____

Abandoned _____


Date

7/16, 1918 *Cumprine* Scout

Map No. _____ Sec. 17 Twp. 28 R. 4Well No. 12 Hocking Farm
Amesbury Company

NORTH

WEST

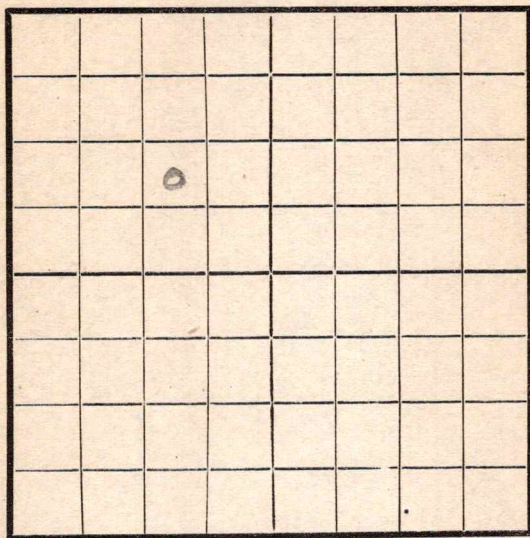

EAST

SOUTH

Location _____

Rig Up _____

Drilling and remarks

22 200

RECORD

Cased _____ in. _____ Ft.

Sand _____

Gas _____

Oil _____

Total Depth _____

PRODUCTION

1st 24 hrs. Nat. _____

1st 24 hrs. after shot _____

Gas _____ Cu. Ft.

Dry Hole _____

Abandoned _____


Date

1/23/1918 Candiff Scout

Map No. _____ Sec. 17 Twp 28 R. 4Well No. 13 Hopkins Farm _____
Empire Company

NORTH

WEST

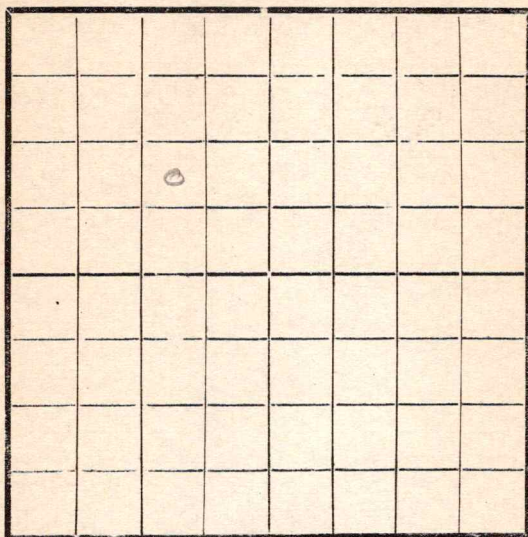

EAST

SOUTH

Location _____

Rig Up _____

Drilling and remarks

690

RECORD

Cased _____ in. _____ Ft.

Sand _____

Gas _____

Oil _____

Total Depth _____

PRODUCTION

1st 24 hrs. Nat. _____

1st 24 hrs. after shot _____

Gas _____ Cu. Ft.

Dry Hole _____

Abandoned _____

Date


1/30, 1918 Landry Scout(2,000,000 cu ft)
(gas at 515)

Map No. _____ Sec. 17 Twp. 28 R. 4Well No. 12 _____ Farm _____

_____ Company _____

NORTH

WEST

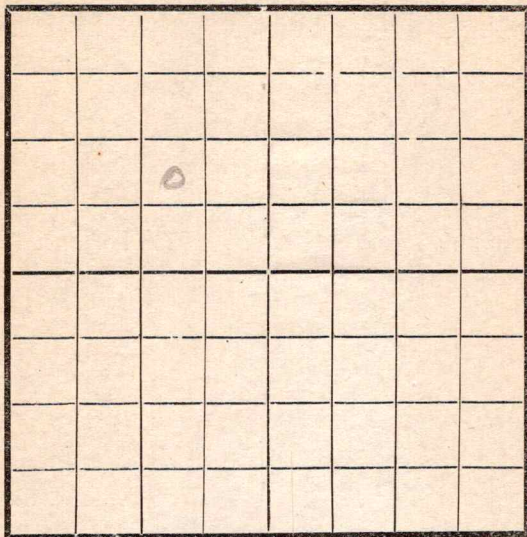

EAST

SOUTH

Location _____

Rig Up _____

Drilling and remarks

720

RECORD

Cased _____ in. _____ Ft.

Sand _____

Gas _____

Oil _____

Total Depth _____

PRODUCTION

1st 24 hrs. Nat. _____

1st 24 hrs. after shot _____

Gas _____ Cu. Ft.

Dry Hole _____

Abandoned _____

Date


2/6, 1918 Scout

Map No. _____ Sec. 26 Twp. 28 R. 4Well No. 12 Hopkins Farm _____

_____ Company

NORTH

WEST

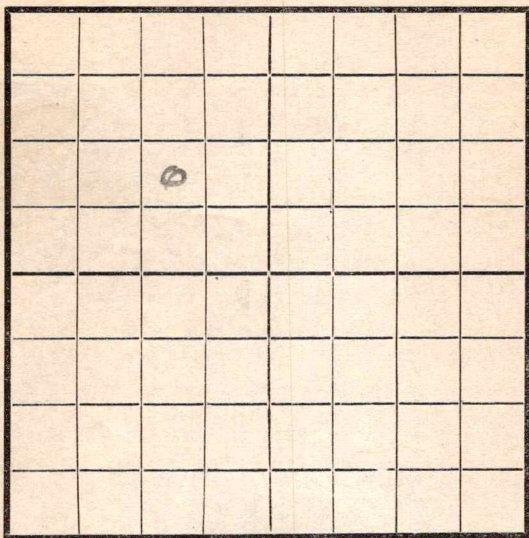

EAST

SOUTH

Location _____

Rig Up _____

Drilling and remarks

1300

RECORD

Cased _____ in. _____ Ft.

Sand _____

Gas _____

Oil _____

Total Depth _____

PRODUCTION

1st 24 hrs. Nat. _____

1st 24 hrs. after shot _____

Gas _____ Cu. Ft.

Dry Hole _____

Abandoned _____

Date

3/3, 1918 C. C. C. Scout


Map No. _____ Sec. 20 Twp. 28 R. 4

Well No. 12 Hoskins Farm

Engine Company

NORTH

WEST

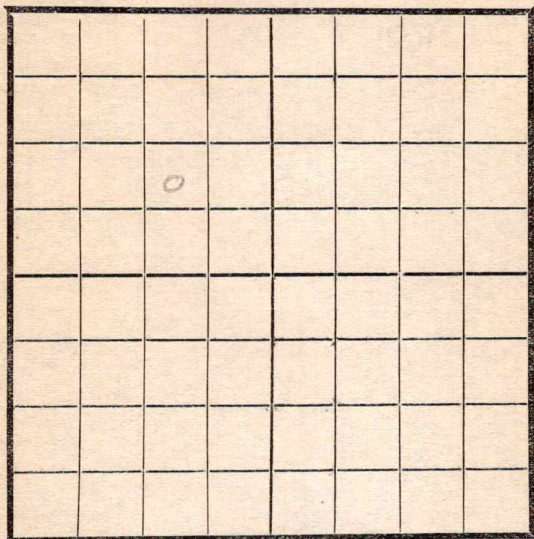

EAST

SOUTH

Location _____

Rig Up _____

Drilling and remarks

SD 1340

RECORD

Cased _____ in. _____ Ft.

Sand _____

Gas _____

Oil _____

Total Depth _____

PRODUCTION

1st 24 hrs. Nat. _____

1st 24 hrs. after shot _____

Gas _____ Cu. Ft.

Dry Hole _____


Abandoned _____

Date

2/27, 1918 S. Candy Scout

Map No. 1511 Sec. 20 Twp. 28 R. 4Well No. 127 Farm Engine Company

NORTH

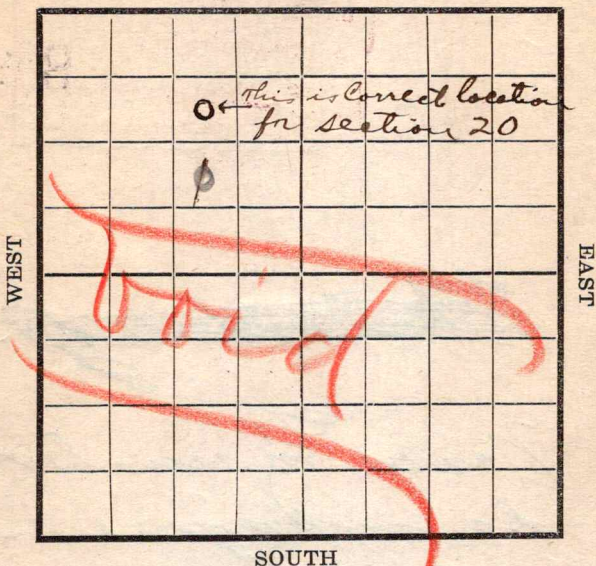

SOUTH

Location -----

Rig Up -----

Drilling and remarks

Should be
in Sec
20-28-4

RECORD

Cased ----- in ----- Ft.

Sand -----

Gas -----

Oil -----

Total Depth -----

PRODUCTION

1st 24 hrs. Nat. -----

1st 24 hrs. after shot -----

Gas ----- Cu. Ft.

Dry Hole -----

Abandoned -----


Date

2/13, 1918 Candys Scout

1002 *K11*
 Map No. *20* Sec. *28* Twp. *4* R. *4*
 Well No. *12 Hart Bros* Farm
Empire Company

NORTH

WEST

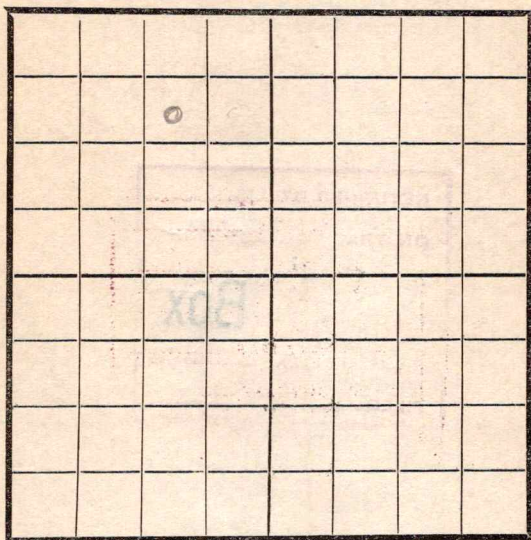

EAST

SOUTH

Location -----

Rig Up -----

Drilling and remarks

1770

RECORD

Cased ----- in. ----- Ft.

Sand -----

Gas -----

Oil -----

Total Depth -----

PRODUCTION

1st 24 hrs. Nat. -----

1st 24 hrs. after shot -----

Gas ----- Cu. Ft.


Dry Hole -----

Abandoned -----

Date

3/6, 191*8* *J. C. Condy* Scout

Map No. _____ Sec. 20 Twp. 28 R. 4
 Well No. 12 Hopkins Farm _____
Carpine Company _____
 NORTH

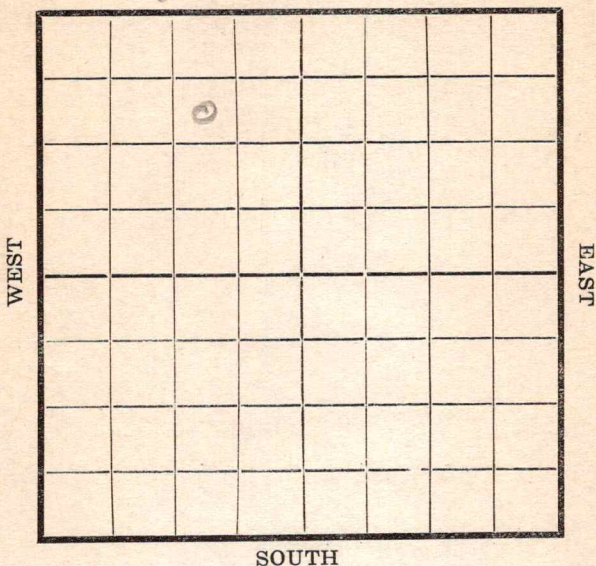

Location _____
 Rig Up _____
 Drilling and remarks

2105

RECORD

Cased _____ in. _____ Ft.
 Sand _____
 Gas _____
 Oil _____
 Total Depth _____

PRODUCTION

1st 24 hrs. Nat. _____
 1st 24 hrs. after shot _____
 Gas _____ Cu. Ft.
 Dry Hole _____
 Abandoned _____

Date 3/13, 1918 S. Conroy Scout


Map No. *K11* Sec. *20* Twp. *28* R. *4*

Well No. *12 Hookins* Farm

Angine Company

NORTH

WEST

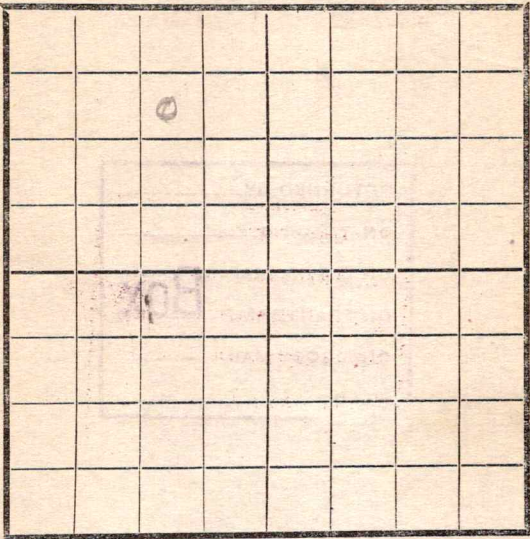

EAST

SOUTH

RECORD

Location -----

Cased ----- in. ----- Ft.

Rig Up -----

Sand -----

Drilling and remarks

Gas -----

Oil -----

Total Depth -----

PRODUCTION

1st 24 hrs. Nat. -----

1st 24 hrs. after shot -----

Gas ----- Cu. Ft.

Dry Hole -----

Abandoned -----


Date

3/20, 191*8* *S. Condy* Scout

Map No. _____ Sec. 20 Twp. 28 R. 4
 Well No. 12 Haskins Farm
Empire Company

NORTH

WEST

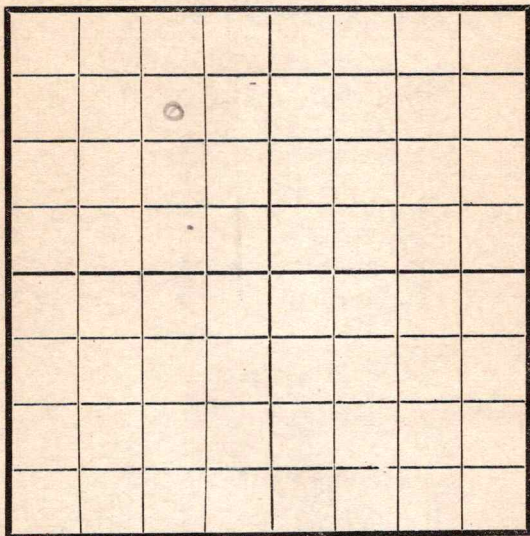

EAST

SOUTH

Location _____
 Rig Up _____
 Drilling and remarks

2270

RECORD

Cased _____ in _____ Ft.
 Sand _____
 Gas _____
 Oil _____
 Total Depth _____

PRODUCTION

1st 24 hrs. Nat. _____
 1st 24 hrs. after shot _____
 Gas _____ Cu. Ft.
 Dry Hole _____
 Abandoned _____


Date

3/27, 1911 S. Condy Scout

Map No. _____ Sec. 20 Twp. 28 R. 4
 Well No. 12 Haskins Farm _____
 _____ Company

NORTH

WEST

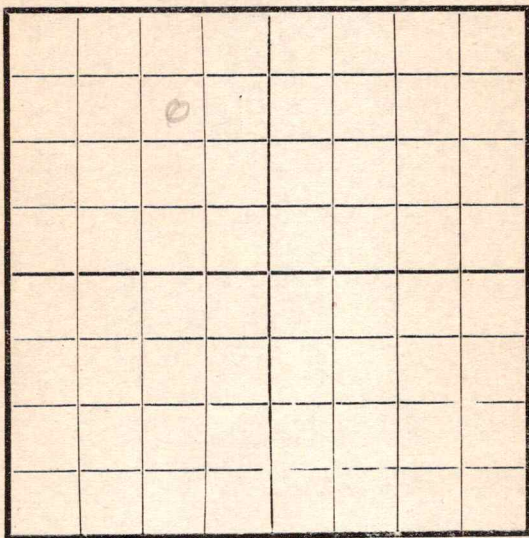

EAST

SOUTH

Location _____
 Rig Up _____
 Drilling and remarks

2355

RECORD

Cased _____ in. _____ Ft.
 Sand _____
 Gas _____
 Oil _____
 Total Depth _____

PRODUCTION

1st 24 hrs. Nat. _____
 1st 24 hrs. after shot _____
 Gas _____ Cu. Ft.
 Dry Hole _____
 Abandoned _____

Date

APR 3 1918
 _____, 191_____

Cord

Scout


Map No. _____ Sec. 30 Twp. 28 R. 4

Well No. 12 Hastings Farm

Cummins Company

NORTH

WEST

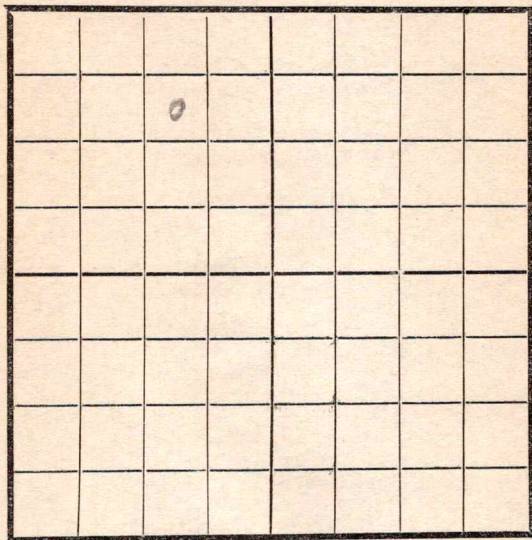

EAST

SOUTH

Location _____

Rig Up _____

Drilling and remarks

2478

RECORD

Cased _____ in _____ Ft.

Sand _____

Gas _____

Oil _____

Total Depth _____

PRODUCTION

1st 24 hrs. Nat. _____

1st 24 hrs. after shot _____

Gas _____ Cu. Ft.

Dry Hole _____

Abandoned _____

Date

4/10, 1918 S. C. Carey Scout


Map No. 1002 H 11 Sec. 20 Twp. 28 R. 4

Well No. 12 Haskins Farm

Empire Company

NORTH

WEST

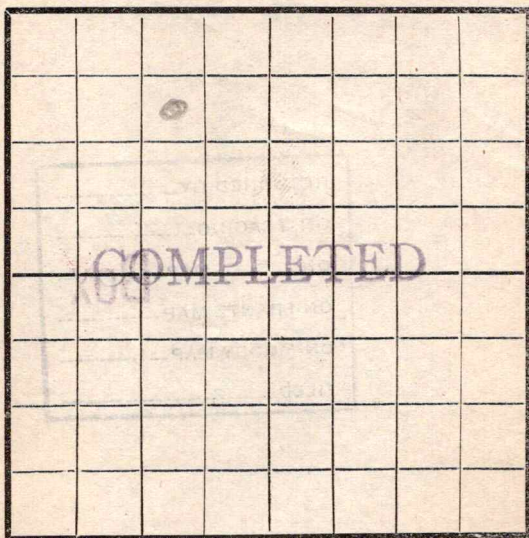

EAST

SOUTH

Location -----

Rig Up -----

Drilling and remarks

*Estimated
at 800
Bbls
saturated*

RECORD

Cased ----- in. ----- Ft.

Sand 2480 - 2491

Gas -----

Oil -----

Total Depth -----

PRODUCTION

1st 24 hrs. Nat. -----

1st 24 hrs. after shot -----

Gas ----- Cu. Ft.

Dry Hole -----

Abandoned -----

Date

4/17, 1918 S. Condy Scout