


Section 32 Township 34 Range 3E

Well No. 11 Baird-Drennen

Company Aladdin Petroleum

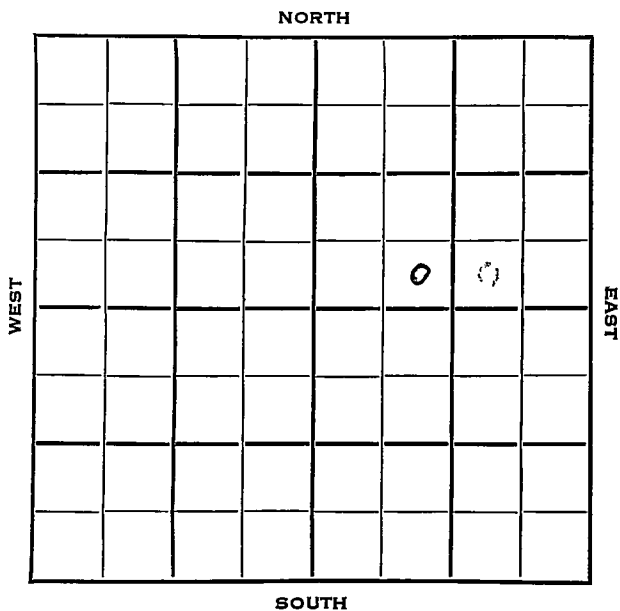

Cowley KANSAS

SEC. 32	TWP. 34	R. E ✓
------------	------------	-----------

WELL NO. 11 Baird-Drennen FARM COMPANY

CONTRACTOR Aladdin Petroleum


Grove Drlg.
Gibson Pool

_____ Ft. from N. Line

330 _____ Ft. from S. Line

_____ Ft. from E. Line

990 _____ Ft. from W. Line

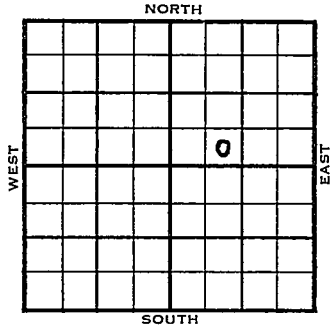

SE SW NE

1954	ELEVATION 1141'	REPORT
------	--------------------	--------

1/27 Spud 1-22-54
8" @ 138'
rlg. 1670'

2/24 Spud 1-22-54
Oil well
TD 3395'
8" @ 138'
Layton 2671' KC 2839', Marm 3051',
Bart 3367', Miss 3392'
TD 3395'
5" @ 3365'
CO to 3387'
Hydro. F/ 35 boph
Comp 1289 bopd.

COMPLETED

