


Section 32 Township 34 Range 3E

Well No. 13 Baird-Drennen

Company Aladdin Petr.

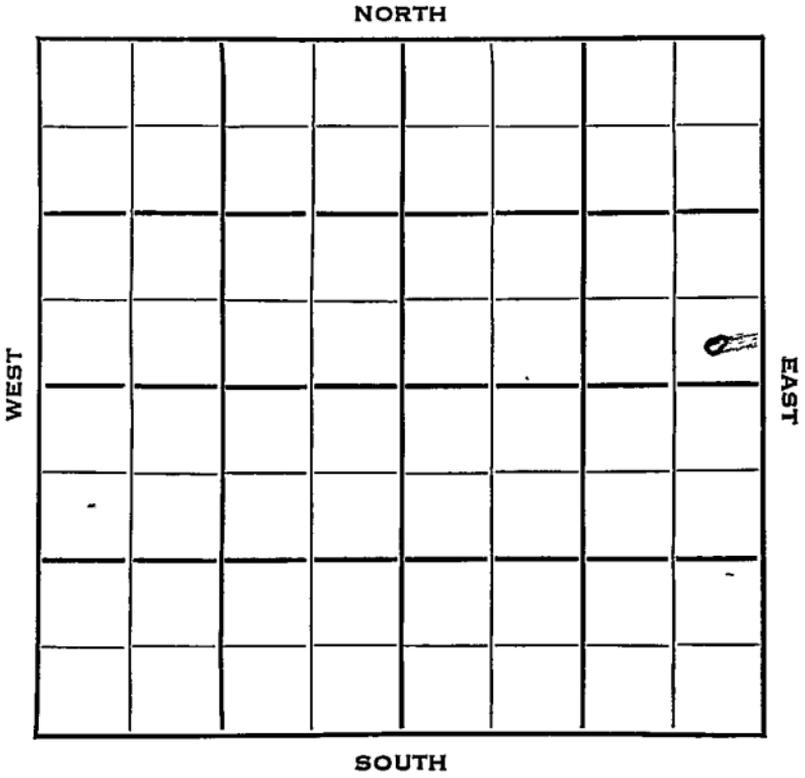

Cowley

KANSAS

SEC.	TWP.	R.
32	34	3 E ✓

WELL NO.

13 Baird-Drennen

FARM

COMPANY

Aladdin Petroleum

CONTRACTOR

Crowe Drlg.

Gibson Pool


_____ Ft. from N. Line

330 _____ Ft. from S. Line

330 _____ Ft. from E. Line

_____ Ft. from W. Line

SE SE NE

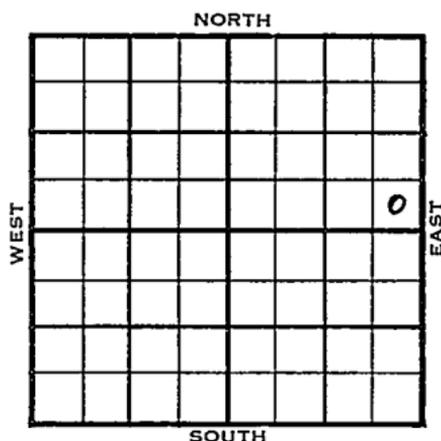

	ELEVATION	REPORT
1954	1151'	
3/31		Spud 3-28-54 8" @ 130 Drlg. 550'
5/19		spud 3-28-54 Oil Well TD 3807' 8" @ 130' KC 2859', Marm 3066', Bart 3376', Miss 3413' DST 3408'-24' opn 1 hr, rec 300' gas, 55' socm, 620# Simp 3752' DST 3739'-78' opn 1 hr, rec 960' gas, 75' hocm 85# Arb 3787', DST 3797'-3802' opn 20 min, rec 300' oil, 60' Wtr. 1515# DST 3802'-07' opn 20 min, rec 150' mco. 1530# TD 3807' 5" @ 3789' CO to 3807' S/ 15 boph F/ 5 boph Comp. 415 bopd.

COMPLETED

County **Cowley** State **Kansas**

Sec. **32** (Blk. Twp.) **34** (Sur. Rge.) **3E** Map No.

Operator **Aladdin Petroleum**

Well No. **13** Farm **Baird-Drennen**

Elev. Location **SE SE NE**

FIRST REPORT

330 Ft. From **S** Line **NE**

330 Ft. From **E** Line **Quarter**

1st. Report **MAR 31 1954**

Completion

Remarks

Crowe Drlg. - Contr.

Spudding Date **3-28-54**

Drlg. Data **Gibson Pool**

8" @ 130 drlg. 550

County Cowley State Kansas
 Sec. 32 (Blk. 34) (Sur. 3E) Map No. 3E
 Operator Aladdin Petroleum
 Well No. 13 Farm Baird-Drennen
 Elev. 1151 Location SE SE NE

				0
COMPLETE				

330 Ft. From S Line NE
330 Ft. From E Line Quarter
 1st. Report
 Completion MAY 19 1954
 Remarks Gibson Pool
Crowe Drlg. - Contr.
 Spudding Date 3-28-54

Drlg. Data Oil well TD 3807
8" @ 130 KC 2859 Marm. 3066
Bart. 3376 Miss. 3413 DST 3408-24
open 1 hr. Rec. 300' gas 55' socm
620# Simp. 3752 DST 3739-78 open 1 hr.
Rec. 960' gas 75' hocm 85# Arb. 3787
DST 3797-3802 open 20 min. Rec. 300' oil
60' wtr. 1515# DST 3802-07 open 20 min
Rec. 150' mco 1530# TD 3807 5" @ 3789
CO to 3807 S/ 15 boph F/ 5 boph
Comp. 415 bopd

J. G. McGEHEE