

Section 32 Township 34 Range 3E

Well No. #17 Baird-Drennen

Company Aladdin Pet.

NORTH

							o
			a				

WEST

EAST

SOUTH

Cowley KANSAS


SEC.	TWP.	R.
32	34	3E

WELL NO. **17 Baird-Drennen** FARM

COMPANY **Aladdin Pet.**

CONTRACTOR **Crowe Drlg.
Gibson Pool**

_____ Ft. from N. Line
990 _____ Ft. from S. Line
330 _____ Ft. from E. Line
 _____ Ft. from W. Line

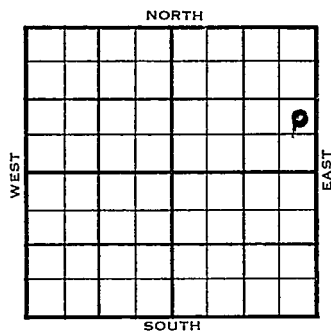

NE SE NE

1954	ELEVATION 1152'	REPORT
8/11	8" @ 130	
10/6		<p>Spud 8-15-54 Oil well TD 2860 8" @ 130 Stal. 2330 Layton 2669 Bart. 3378 Miss 3430 Simp 3710 Simp sd. 3755 Arb. 3798 TD 3860 5" @ 3860 CO 27/3494-99 S/1½ BOPH 12 hr. 500 A F/40 BOPH Comp. BHB 2312 BOPH</p> <p align="center">COMPLETED</p>

