


DX 78-1

Cowley KANS S

Section 32 Township 34 Range 3E
#~~19~~₁₀ Baird-Drennan
Well No. _____
Company Aladdin Petr.

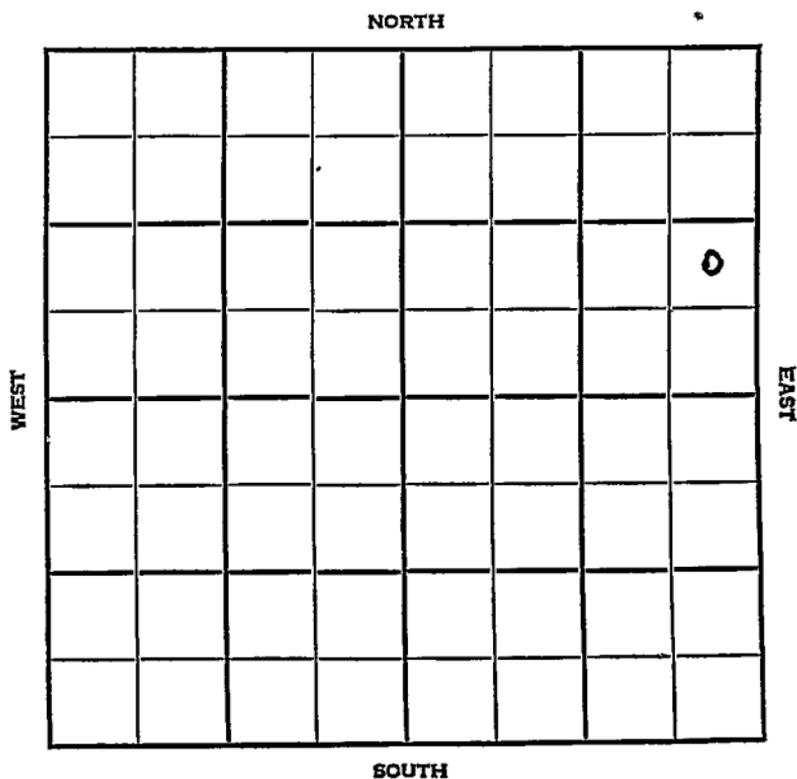

Cowley

KANSAS

SEC.	TWP.	R.
32	34	3 E

WELL NO ~~#18~~ #19 Bair-Drennan FARM

COMPANY Aladdin Pet.

CONTRACTOR Crowe


Gibson Pool

_____ Ft. from N. Line

1065 _____ Ft. from S. Line

330 _____ Ft. from E. Line

_____ Ft. from W. Line

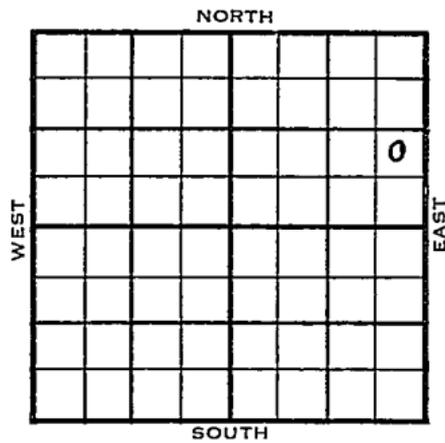

NE SE NE

	ELEVATION	REPORT
1954	1110'	

8/25 Location

9/15 Drlg. 3290'

10/6 Spud 8-28-54 Oil well TD 3402
 8-5/8" @ 123 Layton 2611 KC 2858
 Marm. 3014 Bart. 3367 TD 3398
 5 @ 3368 CO to 3398 sd-frac.
 DD 3402 sd-frac Comp. 730 BOPD

COMPLETED

Map No. _____ Sec. 32 Twp. 34 R. 3E

Well No. 19 Baird-Drennan

Aladdin Pet. Company

CORRECTION Contractor

NE SE NE

SECTION PLAT

_____ Ft. from N. Line

1065 Ft. from S. Line

330 Ft. from E. Line

_____ Ft. from W. Line

			o

Cowley County

Location _____

Rig up _____

Drilling and Remarks:

Reported
#18

RECORD

Cased _____ in., _____ ft.

Sand _____

Gas _____

Oil _____

Total Depth _____

PRODUCTION

1st 24 hrs. Nat. _____

1st 24 hrs. after shot _____

Gas _____ Cu. Ft.

Dry Hole _____

Abandoned _____

Date

OCT 6 1954

FABEN GILSTRAP
Scout

