

Map No. _____ Sec. 20 Twp. 28 R. 4
 Well No. 7 Kirkpatrick Farm
Empire Company

NORTH

WEST

EAST

SOUTH

Location _____

Rig Up _____

Drilling Remarks:

Drilling Remarks:

RECORD

Cased _____ in. _____ ft.

Sand _____

Gas _____

Oil _____

Total Depth _____

PRODUCTION

1st 24 hrs. Nat. _____

1st 24 hrs. after shot _____

Gas _____ cu. ft

Dry Hole _____

Abandoned _____

Map No. _____ Sec. 20 Twp. 28 R. 4
 Well No. 25112 Farm _____
 _____ Company _____

NORTH

WEST								EAST

SOUTH

Location _____
 Rig Up _____
 Drilling and remarks _____

RECORD

Cased _____ in. _____ Ft.
 Sand _____
 Gas _____
 Oil _____
 Total Depth _____

PRODUCTION

1st 24 hrs. Nat. _____
 1st 24 hrs. after shot _____
 Gas _____ Cu. Ft.
 Dry Hole _____
 Abandoned _____

Date 2/12/12
MAR 24 1917
 _____, 191 _____


E. J. Crocker
 _____ Scout

NEW LOCATION

Map No. _____ Sec. 20 Twp. 28 R. 4
 Well No. T. Kirkpatrick Farm
Company Company

NORTH

WEST

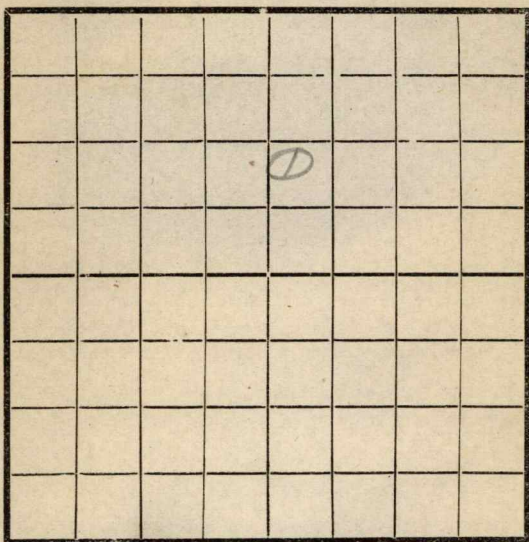

EAST

SOUTH

RECORD

Location _____

Cased _____ in. _____ Ft.

Rig Up _____

Sand _____

Drilling and remarks

Gas _____

Oil _____

Total Depth _____

PRODUCTION

1st 24 hrs. Nat. _____

1st 24 hrs. after shot _____

Gas _____ Cu. Ft.


Dry Hole _____

Abandoned _____

Date

8-21, 1917 Lantz Scout

Map No. _____ Sec. 30 Twp. 28 R. 4
Well No. 7 Kirkpatrick Farm _____
Engine Company _____
NORTH

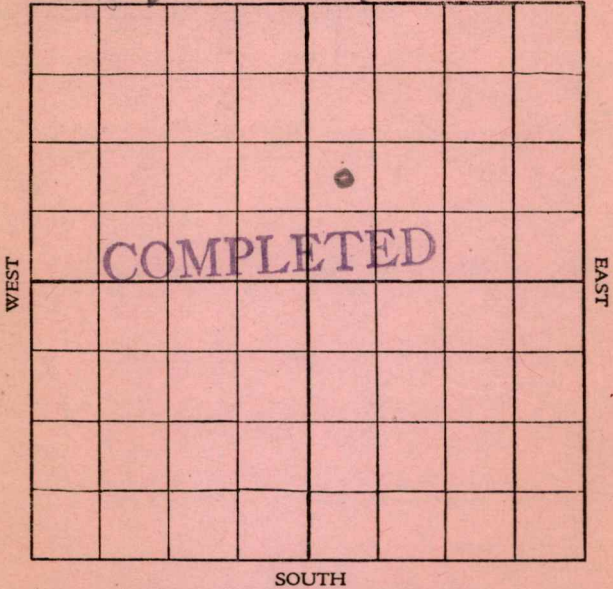

Location _____
Rig up _____
Drilling and remarks:
Est at
200
1366

RECORD
Cased _____ in. _____ Ft.
Sand 2454-2476
Gas _____
Oil _____
Total Depth _____
PRODUCTION
1st 24 hrs. Nat. _____
1st 24 hrs. after shot _____
Gas _____ Cu. Ft.
Dry Hole _____
Abandoned _____

Date 10/9, 1917, Candy Scout