


Section 32 Township 34 Range 3 E

Well No. # 11 Bryant "A"

Company Texas Company

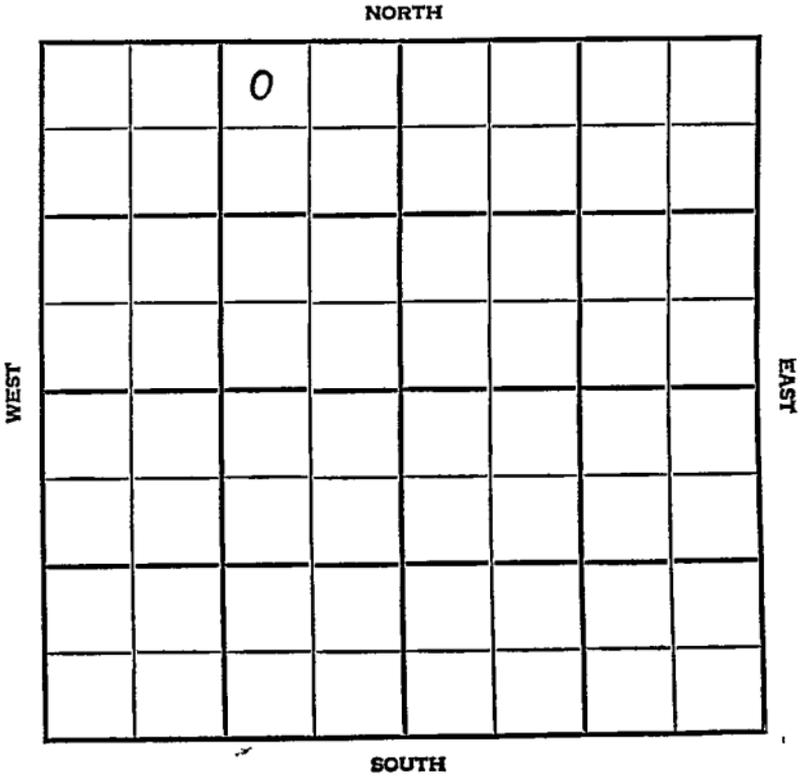

Cowley KANSAS

SEC.	TWP.	R.
32	34	3E

WELL NO. **11 Bryant "A"** FARM

COMPANY **TexasCo.**

CONTRACTOR **Laura Jane**


Gibson Pool

330 _____ Ft. from N. Line

_____ Ft. from S. Line

990 _____ Ft. from E. Line

_____ Ft. from W. Line

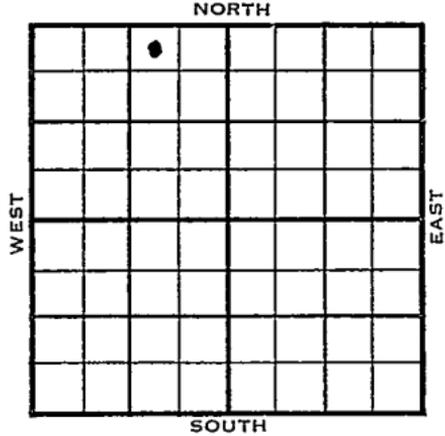

NW NE NW

	ELEVATION	REPORT
1954	1147'	

Miss Test

11/17 Location
 12/22 Spud 11-19-54 Oil well TD 3412
 10" @ 116 Latan 2209 Stal. 2232
 Layton 2636 KC 2878 Cleve 2985
 Marm. 3068 Cherokee 3181 Bart 3364
 TD 3412 7" @ 3411 CU to 3393
 31/3380-90 sd-frac. S/200 B0 20 hr.
 Comp. 81 BOPD.

COMPLETED

County **Cowley** State **Kansas**

Sec. **32** (Blk. Twp.) **34** (Sur. Rge.) **3E** Map No.

Operator **Texas Company**

Well No. **11** Farm **Bryant "A"**

Elev. Location **NW NE NW**

330 Ft. From **N** Line **NW**

990 Ft. From **E** Line **Quarter**

1st. Report **NOV 17 1954**

Completion

Remarks **Miss. test**

Laura Jane - Contr.

Spudding Date

Drig. Data **Gibson Pool**

Location

FABEN GILSTRAP

County Cowley State Kansas

Sec. 32 (Blk. 34) (Sur. 3E) (Twp. 34) (Rge. 3E) Map No.

Operator Texas Company

Well No. 11 Farm Bryant "A"

Elev. 1147 Location NW NE NW

330 Ft. From N Line NW
990 Ft. From E Line Quarter

Ist. Report

Completion DEC 22 1954

Remarks Gibson Pool

Laura Jane - Contr.

Spudding Date 11-19-54

Drilg. Data Oil well TD 3412

10" @ 116 Iatan 2209 Stal. 2232

Layton 2636 KC 2878 Cleve. 2985

Marm. 3068 Cherokee 3181 Bart. 3364

TD 3412 7" @ 3411 CO to 3393

31/ 3380-90 sd-frac S/ 200 bo 20 hr.

Comp. 81 bopd

FABEN GILSTRAP