


Section 8 Township 13 Range 21W

Well No. 1 Geo. Glass

Company Iron Drlg.

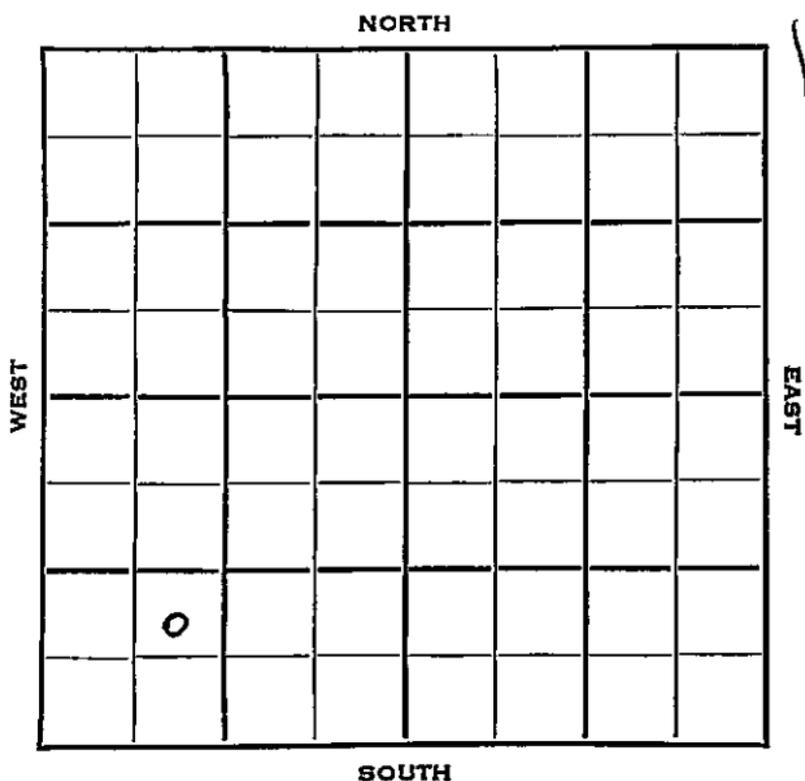

Trego


KANSAS

SEC. 8	TWP. 13	R. 21 W	✓
-----------	------------	------------	---

WELL NO. # 1 Geo. Glass FARM
COMPANY

CONTRACTOR Iron Drlg.

_____ Ft. from N. Line
990 _____ Ft. from S. Line
_____ Ft. from E. Line
990 _____ Ft. from W. Line

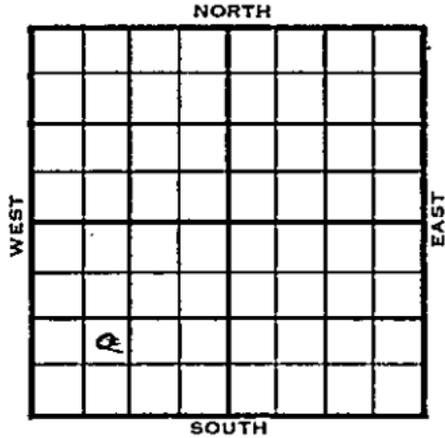

NE SW SW
Stanolind Farmout

1954	ELEVATION 2226'	REPORT
------	--------------------	--------

2/24
3/3
3/10

MIR
8" @ 165 w/120
Drlg. 3304'
Spud 2-25-54 D & A TD 4010
8" @ 165 Heeb 3525 Lans. 3559
Marm. 3888 Cong. 3937 TD 4010
D & A

ABANDONED

County **Trego** State **Kansas**

Sec. **8** (Blk. **13** (Sur. **21W** (Twp.) Rge.) Map No.

Operator **Iron Drlg.**

Well No. **1** Farm **Geo. Glass**

Elev. Location **NE SW SW**



990 Ft. From **S** Line **SW**

990 Ft. From **W** Line Quarter

Ist. Report **FEB 24 1954**


Completion

Remarks **Stanolind farmout**

Spudding Date

Drlg. Data

M I R

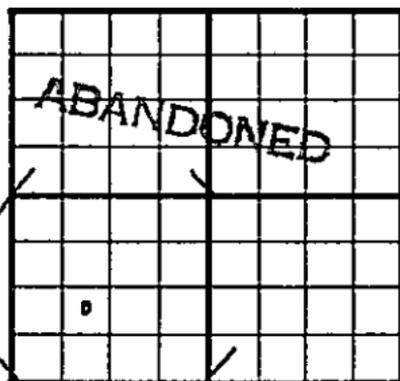County Trego State KansasSec. 8 (Blk.) 13 (Sur.) 21W Map No.Operator Iron Drlg.Well No. 1 Farm Geo. GlassElev. 2226 Location NE SW SW990 Ft. From S Line SW990 Ft. From W Line Quarter

1st. Report

Completion MAR 10 1954

Remarks

Spudding Date 2-25-54Drlg. Data D & A TD 40108" @ 165 Heeb. 3525 Lans. 3559Marm. 3888 Cong. 3937 TD 4010D & A