


Section 32 Township 34 Range 3 E

Well No. # 18 Baird-Drennen

Company Aladdin Pet.

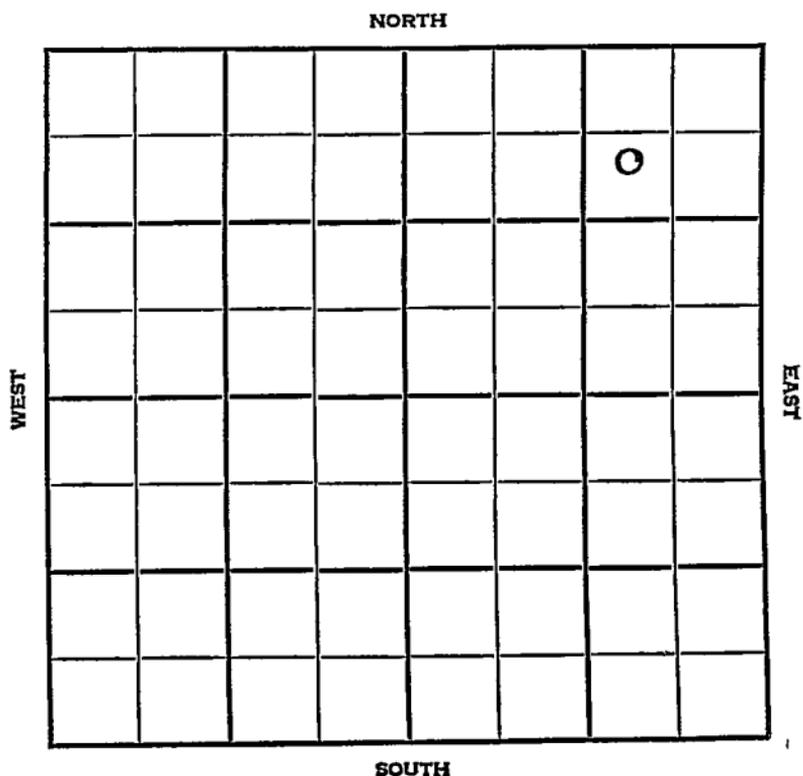

Cowley KANSAS

SEC.	TWP.	R.
32	34	3 E

WELL NO. # 18 Baird-Drennan FARM

COMPANY Aladdin Pet.

CONTRACTOR Crowe

Gibson Pool


815 \_\_\_\_\_ Ft. from N. Line

\_\_\_\_\_ Ft. from S. Line

990 \_\_\_\_\_ Ft. from E. Line

\_\_\_\_\_ Ft. from W. Line

SW NE NE

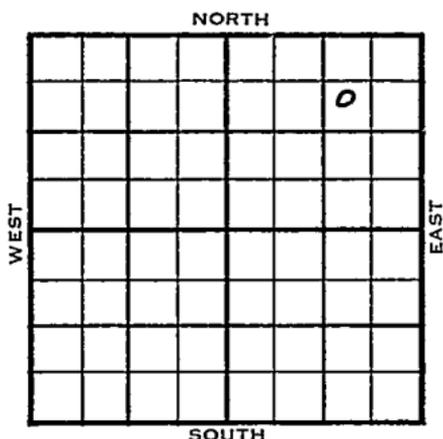

1954	ELEVATION 1152'	REPORT
------	--------------------	--------

10/6 Spud 9-7-54  
 Oil well TD 3402 8" @ 126  
 Layton 2680 KC 2862 Marm 3070'  
 Bart 3377 TD 3402 5" @ 3377 frac.  
 Comp. 759 BOPD

**FIRST REPORT**  
 ↓  
**COMPLETED**


County Cowley State Kansas

Sec. 32 (Blk. Twp.) 34 (Sur. Rge.) 3E Map No.

Operator Aladdin Pet.

Well No. 18 Farm Baird Drennan

Elev. 1152 Location SW NE NE

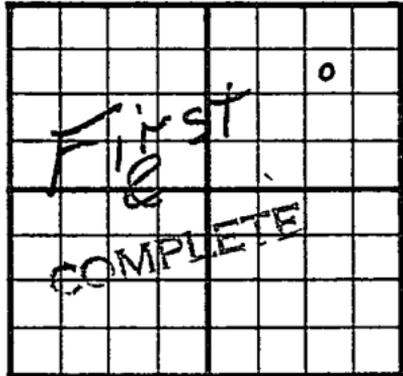

815 Ft. From N Line NE

990 Ft. From E Line Quarter

Ist. Report

Completion OCT 6 1954

Remarks Gibson Pool

Crowe - Contr.

Spudding Date 9-7-54

Drilg. Data Oil well TD 3402

8" @ 126 Layton 2680 KC 2862

Marm. 3070 Bart. 3377 TD 3402

5" @ 3377 frac Comp. 759 bopd

FABEN GILSTRAP