


Section 6 Township 13 Range 21W

Well No. #1 Seiver SIEBEL

Company C & G Drlg. & Bradley

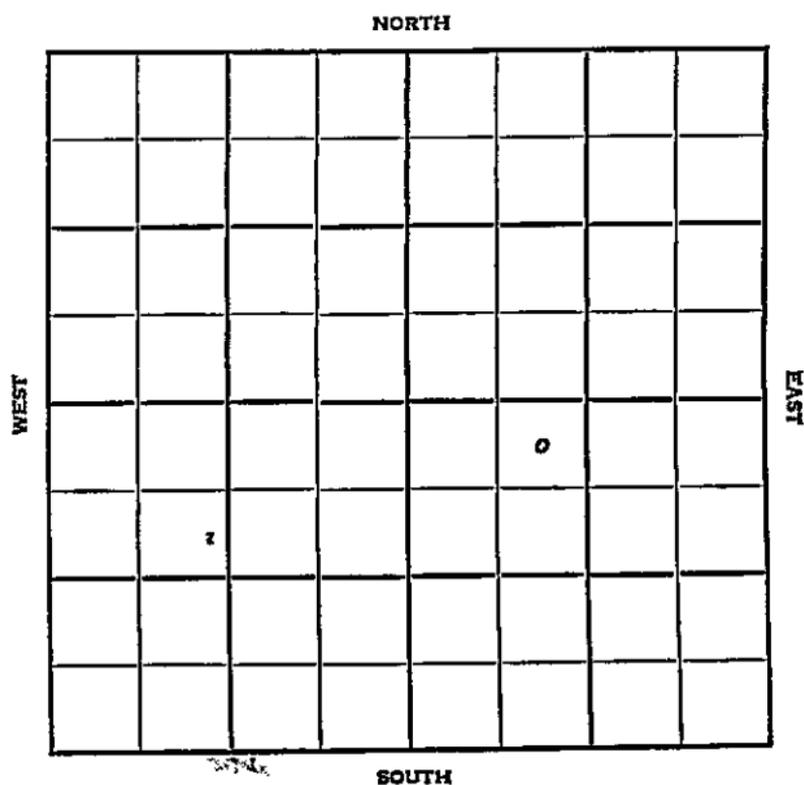

Trego

KANSAS

SEC.	TWP.	R.
6	13	21 W

WELL NO.

1 Seivel ~~SEIBEL~~

FARM

COMPANY

C & G Drlg. & Bradley

CONTRACTOR

C & G Drlg.

Wildcat


330 _____ Ft. from N. Line

_____ Ft. from S. Line

_____ Ft. from E. Line

990 _____ Ft. from W. Line

NE NW SE

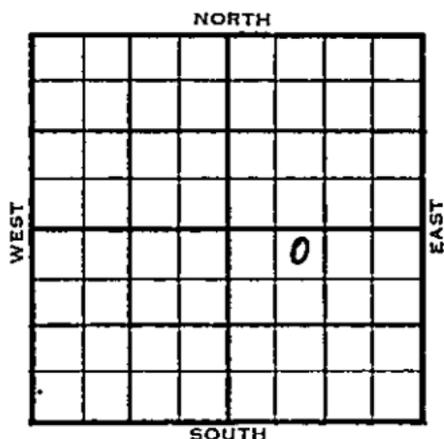

CSO - DHM

	ELEVATION	REPORT
1955	2276'	
2/9	Spud 2-5-55 8" @ 184'	Anhy 1700
2/16	Drlg. 2335' Spud 2-5-55 D & A TD 3991' 8" @ 184'	Anhy 1700', Top 3335' Heeb 3563 Lans 3599' B KC 3840' Cong 3972' DST 3976'-91' opn 1 hr, rec 35' Mud O# TD 3991' D & A
		ABANDONED

County **Trego** State **Kansas**

Sec. **6** (Blk. Twp.) **13** (Sur. Rge.) **21W** Map No.

Operator **C & G Drlg. & Bradley**

Well No. **1** Farm **Seivel**

Elev. Location **NE NW SE**

330 Ft. From **N** Line **SE**

990 Ft. From **W** Line Quarter

Ist. Report **FEB 9 1955**

Completion

Remarks. **CSO - DEM**

C & G Drlg. - Contr.


Spudding Date **2-5-55**

Drlg. Data **Wildcat**

8" @ 184 Anhy 1700 drlg. 2335

FABEN GILSTRAP

County Trego State Kansas
 Sec. 6 (Blk. 13) (Sur. 21W) (Twp.) (Rge.) Map No.
 Operator C & G Drlg. & Bradley
 Well No. 1 Farm Siebel
 Elev. 2276 Location NE NW SE

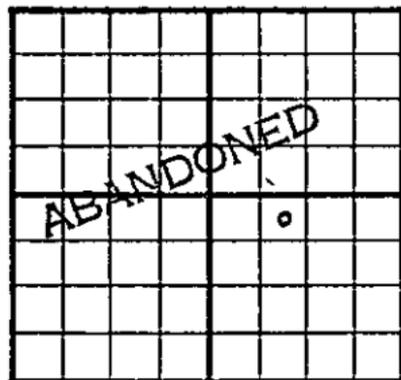330 Ft. From N Line SE990 Ft. From W Line Quarter

1st. Report

Completion FEB 16 1955Remarks WildcatC & G Drlg. - Contr.Spudding Date 2-5-55Drlg. Data D & A TD 39918" @ 184 Anhy 1700 Top. 3335Heeb. 3563 Lans. 3599 B KC 3840Cong. 3972 DST 3976-91 open 1 hr.Rec. 35' mud O# TD 3991D & A

FABEN GILSTRAP