




Empire Company

NORTH

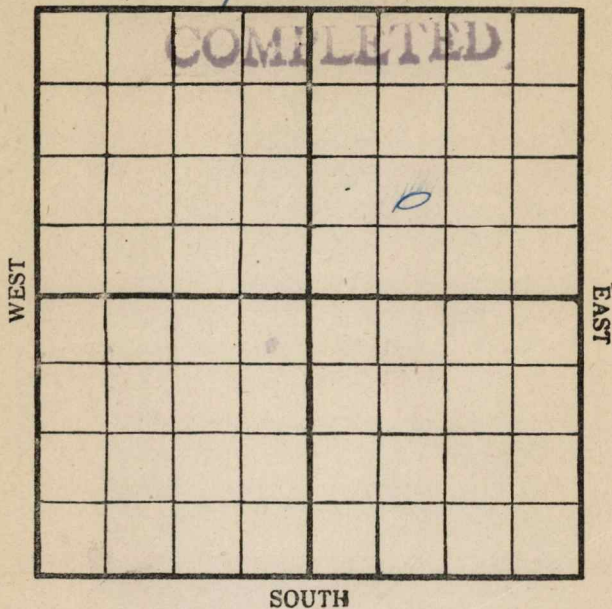

Location, -----

Drilling Remarks:

Rig Up-----

Drilling Remarks:

RECORD

Cased_____ in._____ft.

Sand -----

Gas: _____

Oil -----

Total Depth_____

PRODUCTION

1st 24 hrs. Nat.-----

1st 24 h.s. after shot-----

Gas_____cu. ft

Dry Hole_____


Abandoned -----

Map No. _____ Sec. 20 Twp. 28 R. 4
 Well No. 8 Kirkpatrick Farm
Empire Company

NORTH

WEST

EAST

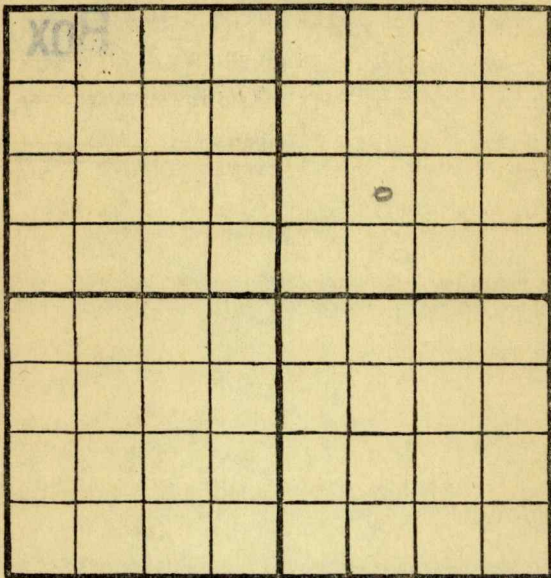

SOUTH

Location _____

Rig Up ☒ _____

Drilling and remarks

RECORD

Cased _____ in. _____ Ft.

Sand _____

Gas _____

Oil _____

Total Depth _____

PRODUCTION

1st 24 hrs. Nat. _____

1st 24 hrs. after shot _____

Gas _____ Cu. Ft.

Dry Hole _____

Abandoned _____

FIRST REPORT

Date

9/19, 1917, Candoff Scout


Map No. _____ Sec. 20 Twp. 28 R. 4

Well No. 8 Kirkpatrick Farm _____

Engine Company _____

NORTH

WEST

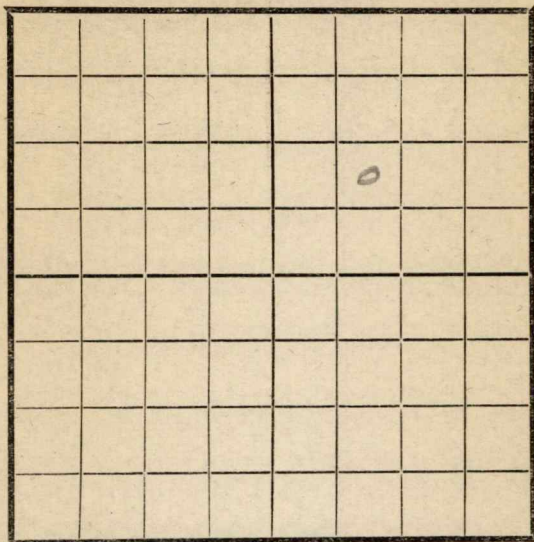

EAST

SOUTH

Location _____

Rig Up _____

Drilling and remarks

125

RECORD

Cased _____ in. _____ Ft.

Sand _____

Gas _____

Oil _____

Total Depth _____

PRODUCTION

1st 24 hrs. Nat. _____

1st 24 hrs. after shot _____

Gas _____ Cu. Ft.

Dry Hole _____

Abandoned _____

Date


10/9, 1917 Cardiff Scout _____

Map No. _____ Sec. 20 Twp. 28 R. 4
Well No. 85 Kipholia Farm _____
Engine Company _____

NORTH

WEST

EAST

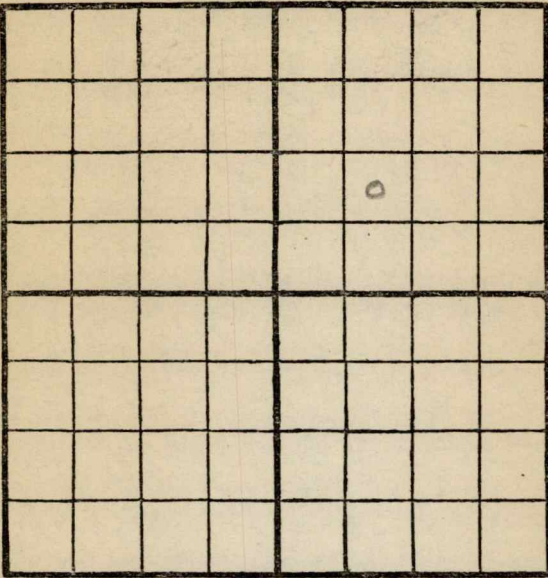

SOUTH

Location _____
Rig Up _____
Drilling and remarks

680

RECORD

Cased _____ in. _____ Ft.
Sand _____
Gas _____
Oil _____
Total Depth _____

PRODUCTION


1st 24 hrs. Nat. _____
1st 24 hrs. after shot _____
Gas _____ Cu. Ft.
Dry Hole _____
Abandoned _____

Date 10/17, 1912, C. S. Siff Scout

L1002
 Map No. K11 Sec. 20 Twp. 28 R. 4
 Well No. S Kirkpatrick Farm
Empire Company

NORTH

WEST

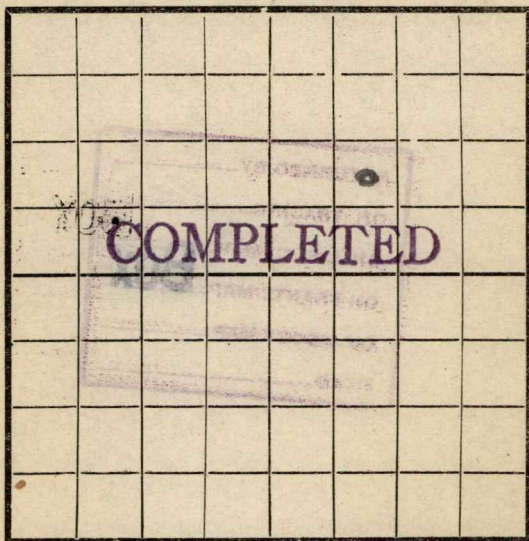

EAST

SOUTH

Location -----

Rig Up -----

Drilling and remarks

Est at
70 Bbls

RECORD

Cased ----- in. ----- Ft.

Sand 2436-2445

Gas -----

Oil -----

Total Depth -----

PRODUCTION

1st 24 hrs. Nat. -----

1st 24 hrs. after shot -----

Gas ----- Cu. Ft.

Dry Hole -----

Abandoned -----


Date

11/21, 191 7 *Carley* Scout

Map No. _____ Sec. 20 Twp. 28 R. 4
 Well No. 8 Kirkpatrick Farm _____
 _____ Company

NORTH

WEST

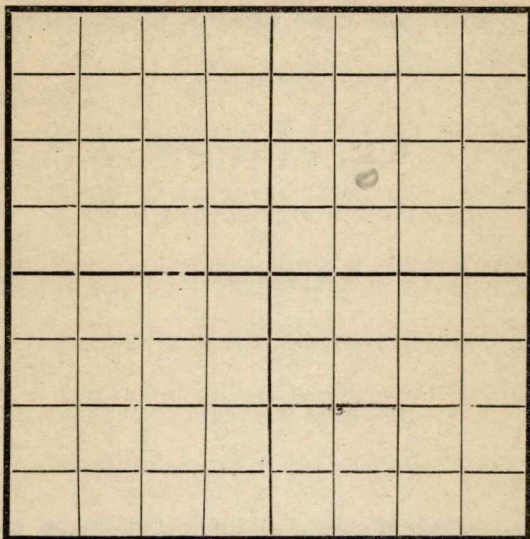

EAST

SOUTH

Location _____

Rig Up _____

Drilling and remarks

1195

RECORD

Cased _____ in. _____ Ft.

Sand _____

Gas _____

Oil _____

Total Depth _____

PRODUCTION

1st 24 hrs. Nat. _____

1st 24 hrs. after shot _____

Gas _____ Cu. Ft.

Dry Hole _____

Abandoned _____

Date

1/24/24, 191 7 Caniff Scout


Map No. _____ Sec. 20 Twp. 28 R. 4

Well No. 8 Hickory Farm

Engine Company

NORTH

WEST

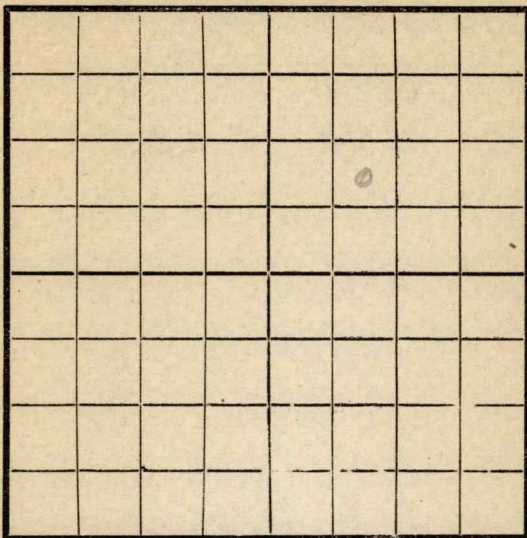

EAST

SOUTH

Location _____

Rig Up _____

Drilling and remarks

1660

RECORD

Cased _____ in. _____ Ft.

Sand _____

Gas _____

Oil _____

Total Depth _____

PRODUCTION

1st 24 hrs. Nat. _____

1st 24 hrs. after shot _____

Gas _____ Cu. Ft.

Dry Hole _____

Abandoned _____


Date

10/31, 1912 Carley Scout

Map No. _____ Sec. 20 Twp. 28 R. 4
 Well No. 8 Kirtznerich Farm
Engineering Company

NORTH

WEST

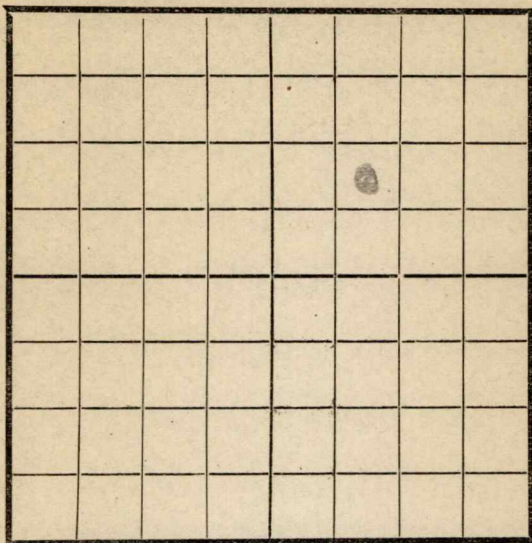

EAST

SOUTH

Location _____
 Rig Up _____
 Drilling and remarks

RECORD

Cased _____ in _____ Ft.
 Sand _____
 Gas _____
 Oil _____
 Total Depth _____

PRODUCTION


1st 24 hrs. Nat. _____
 1st 24 hrs. after shot _____
 Gas _____ Cu. Ft.
 Dry Hole _____
 Abandoned _____

Date

1/7, 1912 Condy Scout

Map No. _____ Sec. 20 Twp. 28 R. 4
 Well No. 8 Kirkpatrick Farm _____
Angus Company _____

NORTH

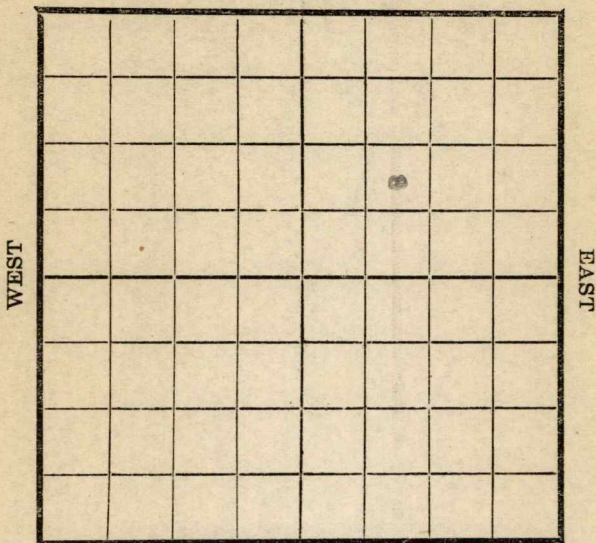

SOUTH

Location _____
 Rig Up _____
 Drilling and remarks

2310

RECORD

Cased _____ in. _____ Ft.
 Sand _____
 Gas _____
 Oil _____
 Total Depth _____

PRODUCTION

1st 24 hrs. Nat. _____
 1st 24 hrs. after shot _____
 Gas _____ Cu. Ft.
 Dry Hole _____
 Abandoned _____

Date

11/14, 1917 Cardiff Scout