

Trego


KANSAS

FORM 51 IOM 12-46 PETROL

Section 12 Township 13 Range 21W

Well No. 1 Egger "a"

Company Bridgeport

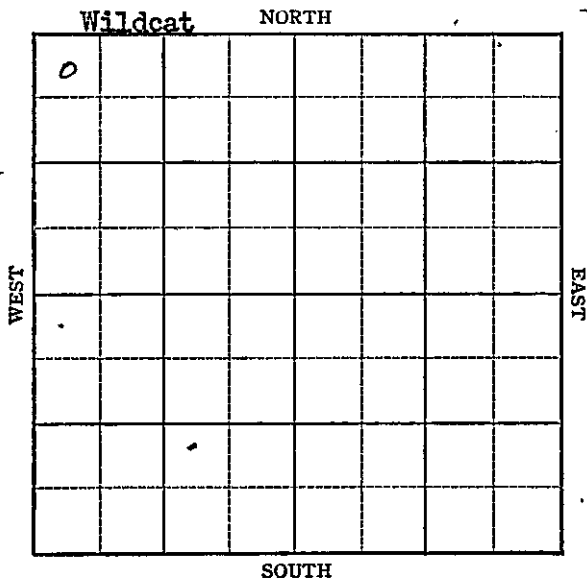

KANSAS

Trego



Sec. 12 Twp. 13 R. 21-N

Well No. #1 Trego "A" Farm


Bridgeport Company

330 Ft. from N. Line

 Ft. from S. Line

 Ft. from E. Line

330 Ft. from W. Line

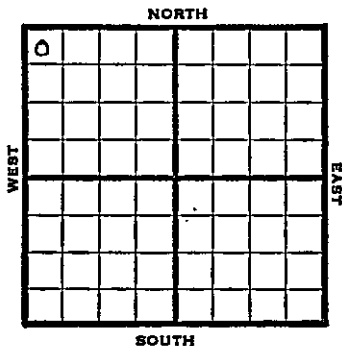

NW $\frac{1}{4}$ C

1947 Elev. 21715 REPORT

4/23 Location

4/29

5/13 Topeka 3176'
Lansing 3456'
Drlg. 3486'


5/21 Cong 3820
Reagan 3872
Granite 3884
TD 3887'

ABANDONED

KANSAS Wildcat
KansasMap No. K70 Sec. 12 Twp. 13 R. 21WWell No. 1 Egger "A"Bridgeport CompanyFIRST REPORT Contractor

NW/C

SECTION PLAT

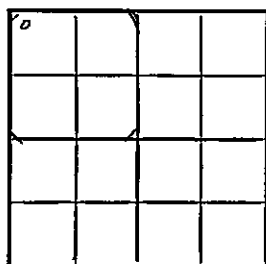330 Ft. from N. Line Ft. from S. Line Ft. from E. Line330 Ft. from W. LineTrego CountyLocation XRig up

Drilling and Remarks:

RECORD

Cased in., ft.Sand Gas Oil Total Depth

PRODUCTION

1st 24 hrs. Nat. 1st 24 hrs. after shot Gas Cu. Ft.Dry Hole Abandoned

Date

APR 23 1947 19S. J. LEWIS Scout

Map No. 1570 Sec. 12 Twp. 13 R. 21W

Well No. 1 Egger "A"

Bridgeport Company
ABANDONED

Contractor
NW/C E. J. 2/7/
SECTION FLAT

330 Ft. from N. Line

 Ft. from S. Line

 Ft. from E. Line

330 Ft. from W. Line

△			

Trego County

Location

Rig up

Drilling and Remarks:

Cong 3820
Reagan 3872
Granite 3884

RECORD

Cased in., ft.

Sand

Gas

Oil

Total Depth 3887

PRODUCTION

1st 24 hrs. Nat.

1st 24 hrs. after shot

Gas Cu. Ft.

Dry Hole

Abandoned

Date

MAY 21 1947

19

S. J. LEWIS

Scout