


Section 32 Township 34 Range 3E

Well No. #9 L. M. Bryant "A"

Company Texas Company

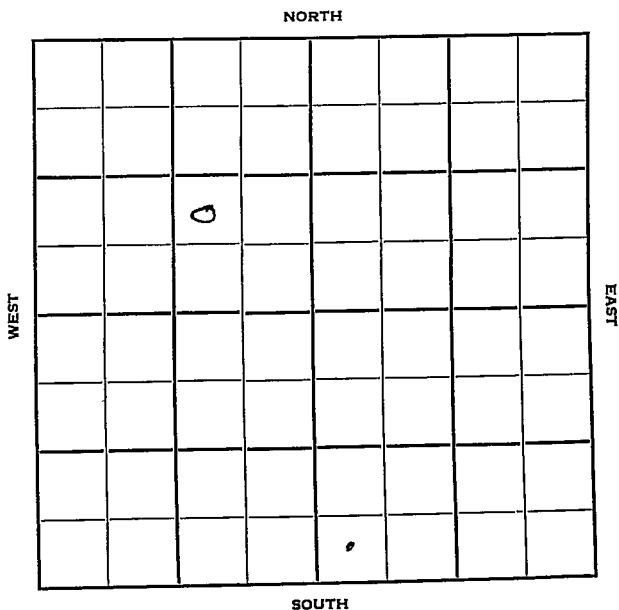

Cowley

KANSAS

Sec. 32 Twp. 34 R. 3E

Well No. #9 L. M. Bryant "A" Farm

Texas Company Company

Stickle Drlg. Contractor


Ft. from N. Line

990 Ft. from S. Line

990 Ft. from E. Line

Ft. from W. Line

NW $\frac{1}{4}$ NW SE NW

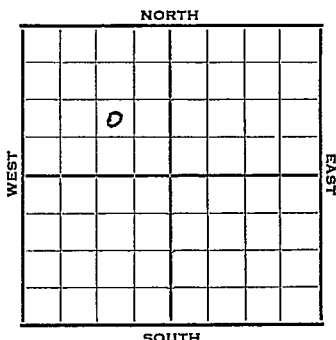

1952 Elev. 1159' REPORT

10/29 Cellar & Pits

12/17 Spud 11-10-52

SDW Well

TD 3921

10" @ 119

Miss 3421

DST 3430-43, opn 1 $\frac{1}{2}$ hrs., rec.

350' mud 10' wtr 590#

Bart 3382

DST 3780-95, opn 2 hrs., rec.

15' vsocm, 40#

DST 3790-3805, opn 2 hrs. rec.

35' mud 30#

DST 3776-88, opn 2 hrs., rec.

40' mud, 50#

DST 3815-40, opn 1 hr., rec.

180' mud 430' muddy sw 2035' sw

DST 3842-56 opn 1 hr., rec. 441'

sul wtr 1400#

Simp 3755, Arb 3821

DST 3857-3920, opn 1 hr., rec.

3165' sw 1400#

TD 3921

7" @ 3853

GO to 3921

Comp. for SWD Well

ABANDONED

J. G. McGEHEE

