
DX 78-1 Trego

KANSAS

Section 21 Township 13S Range 21W

Well No. #1 Bollig

Company Strata, CRA, A.R. Peters, Spencer Chem

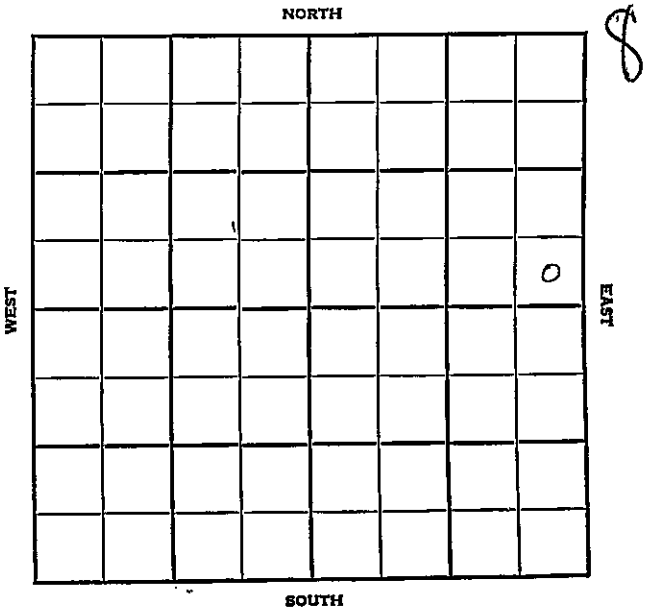

Trego KANSAS

SEC.	TWP.	R.
21	13	21W


WELL NO. #1 Bollig FARM

COMPANY CRA;($\frac{1}{2}$); Strata (1/8); A.R.Peters (1/8);

CONTRACTOR Spencer Chem. ($\frac{1}{4}$);

Strata

WILDCAT

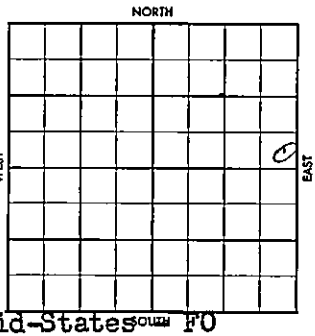

_____ FT. FROM N. LINE

_____ FT. FROM S. LINE

_____ FT. FROM E. LINE

_____ FT. FROM W. LINE

SE SE NE

Mid-States Oil Co FO
Texas - Support

1956	ELEVATION 2281 KB	REPORT

4100' Arb. test

8-29 Comm. 8-26-56
8" @ 205 w/150
Drlg. 1455

9-5 Comm 8-26-56
Tops:
Anh 1675, H 3568, L 3604, C 3940,
A 3996
TD 4005,
Log Tops:
H 3568, L 3604, BKC 3852, Marm
3928, C 3938, SSO 3995
TD 4014
~~Log Tops~~
~~H 3568, L 3604, BKC 3852, Marm~~
8" @ 205 w/150
D 1455
DST 3676-97 30" rec 30' md BHP
1175
DST 3994-4005 1 hr rec 180'
MSW 60-145 BHP 1015-20

COMPLETED

FORM 504-S SUNRAY

FORM 513 SUNRAY

County Trego Elev.

Sec. 21 Twp. 13S Rge. 21W

Company Strata (1/8) CRA (1/2) A.R. Peters (1/8) Spencer Chem. 1/4)

Farm Name Bollig No. 1

TOPS	DEPTH	LOG	DATUM
Anh.			
T.P.			
H.			
Tr.			
Dg.			
B.L.			
L.			
K.C.			
B.K.C.			
Ce.			
C.			
M.			
M.			
K.			
Mz.			
Mo.			
V.			
S.			
S.			
A			
R.			
P€.			
G.			

Loc. in Sec.

SE SE NE

DS - NE¼

McWilliams-Steincamp

Geol. B. G.

Contr.

Strata

Pool

Wildcat



T.D.

Date Comm. 8-26-56 Seismo & subsurface; 4100' Arb. test

Texas - support MidStates-FO

8" 205 w/150; D 1455

932

Co. Lse. No. Sec. T. R.

FORM 515 SUNRAY

County Tyler Elev. 2281 KB

Sec. 21 Twp. 13S Rge. 21W

Company Strata (1/8) CRA (1/2) A.R. Peters (1/8) Spencer Chem. 1/4)

Farm Name Bollig No. 1

TOPS	DEPTH	LOG	DATUM
Anh.	1675		
Tp.			
H.	3568	3568	
Tr.			
Dg.			
Bl.			
L.	3604	3604	
K.C.			
B.K.C.		3852	
Ce. Marm		3928	
C.	3940	3938	
M.			
M.			
K.			
Mz.			
Mo.			
V.			
S.			
S.			
A	3996	sso 3995	
R.			
P€.			
G.			
TD	4033	4014	

Loc. in Sec. SE SE NE

~~DS — NE¼~~

McWilliams-Steifcamp

Geol. B. G.

Contr. Strata

Pool Wildcat

SEP 5 '56

ABANDONED

8-26-56

Date Comm. Seismo & subsurface; 4100' Arb. test

Texas - support MidStates-FD

8" 205 w/150; D 1155 SEP 5 '56 DST

3676-97 30" rec. 30' Md BHP

1175 DST 3994-4005 1hr. rec

180' MSW 60-145 BHP 1065-1/2

RGA

Co. Lse. No. Sec. T. R.