


Section 32 Township 34 Range 3E
Well No. 13 L. M. Bryant "A"
Company Texas Co.

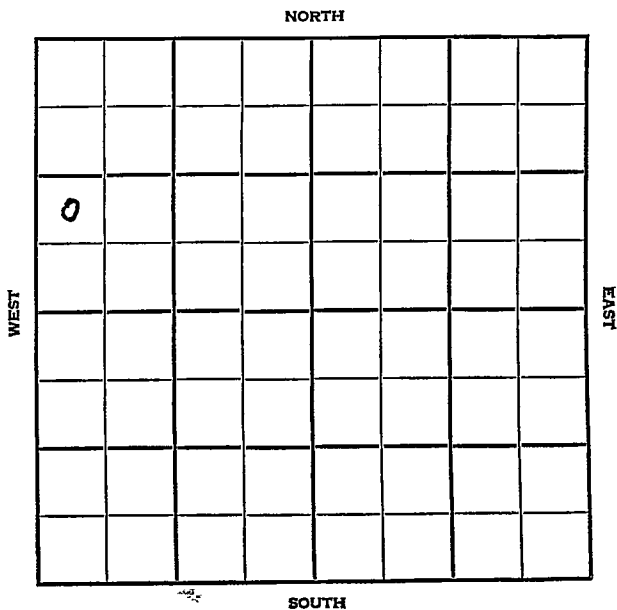

Cowley

KANSAS

SEC.	TWP.	R.
32	34	3E

WELL NO.

#13 L.M. Bryant "A"

FARM

COMPANY

Texas Company

CONTRACTOR

Capitt

Gibson Pool


NORTH

_____ Ft. from N. Line

990 _____ Ft. from S. Line

_____ Ft. from E. Line

330 _____ Ft. from W. Line

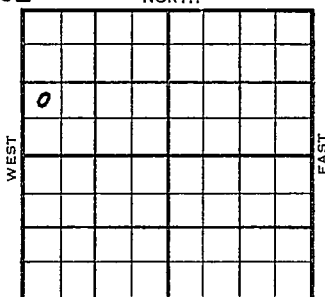

NW SW NW

ELEVATION

1955

1156'

REPORT

4/20

Spud 4-17-55

10" @ 128'

Drlg. 1080'

5/25

Spud 4-17-55

10" @ 128 5" @ 3436

CO to 3424 32/3410-18 3 GW 4 hr.

200 A S/84 B0 31 BW 8 hr.

Comp. 106 BOPD 67 BW

SEEK Tops: Bart 3399', Kans. City 2650'

Lay. 2695', Cherokee 3210',

Miss. 3436',

TD 3436' - Comp.

COMPLETED

County Cowley State KansasSec. 32 (Blk.) 34 (Sur.) 3E Map No.Operator Texas CompanyWell No. 13 Farm L. M. Bryant "A"Elev. Location NW SW NW

990 Ft. From S Line NW330 Ft. From W Line Quarter1st. Report APR 20 1955

Completion

Remarks

Capitt - Contr.Spudding Date 4-17-55Drlg. Data Gibson Pool10" @ 128 drlg. 1080

FABEN GILSTRAP

COMPLETED


County Cowley Elev. 1156
 Sec. 32 Twp. 34 Rge. 3E
 Company Texas Company
 Farm Name L. M. Bryant "A" No. 13

TOPS	DEPTH	DATUM
Cim. Anhydrite		
Ft. Riley		
Howard <u>Bart</u>	<u>3399</u>	<u>2243</u>
Topeka		
Heebner Sh.		
Toronto Ls.		
Brown Lime		
Lansing		
Kans. City	<u>2650</u>	<u>1494</u>
B. K. C. <u>Lay.</u>	<u>2695</u>	<u>1539</u>
<u>cong. Cherokee</u>	<u>3210</u>	<u>2054</u>
Miss. <u>1</u>	<u>3436</u>	<u>2280</u>
Kinderhook		
Misener		
Hunton		
Sylv. Maquo		
Viola		
Simpson		
Smp.		
Gorham		
Arbuckle		
Basal Sand		
Pre. Cam.		
T. D.	<u>3436</u>	

Loc. in Section NW SW NW

Drlg. Contr. Capitt

Pool Gibson

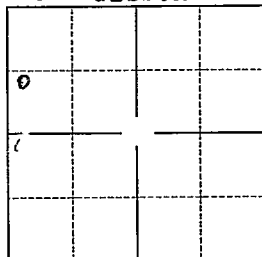

Date Comm. MAY 25 '55

Date Comp. MAY 25 '55

Spud 4-17-55 10" @ 128 5" @ 3436
 CO to 3424 32/ 3410-18 3 gw 4 hr.
 200 A S/ 84 bo 31 bw 8 hr.
 Comp. 106 bopd 67 bw