


Section 32 Township 34 Range 3E

Well No. #11 L. M. Bryant "A"

Company Texas Company

NORTH

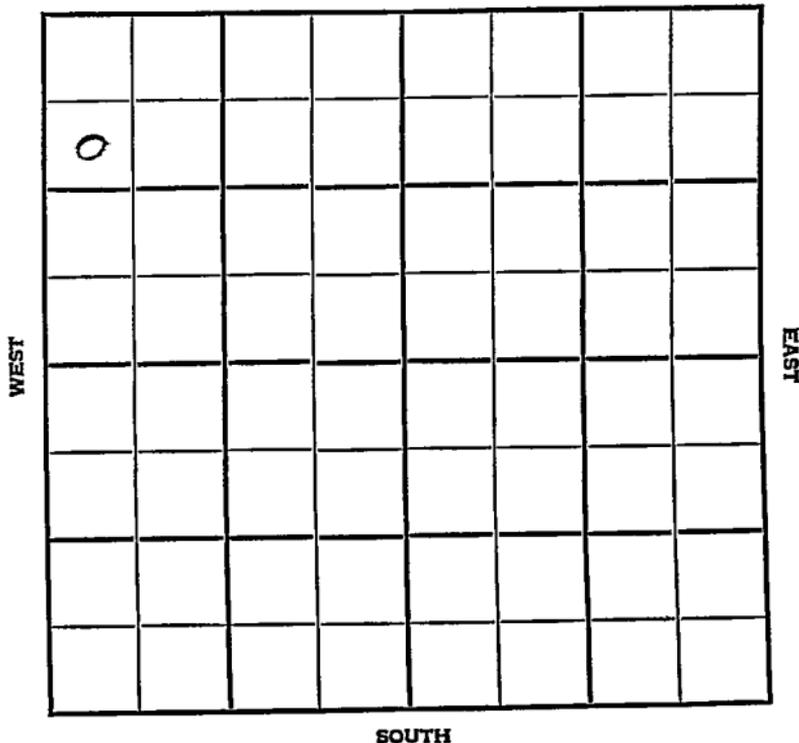

Cowley

KANSAS

SEC.	TWP.	R.
32	34	3E

WELL NO \_\_\_\_\_  
 COMPANY 14 L. M. Bryant "A" FARM

CONTRACTOR Texas Co.

Capitt

Gibson Pool


990' \_\_\_\_\_ Ft. from N. Line

\_\_\_\_\_ Ft. from S. Line

\_\_\_\_\_ Ft. from E. Line

330' \_\_\_\_\_ Ft. from W. Line

SW NW NW

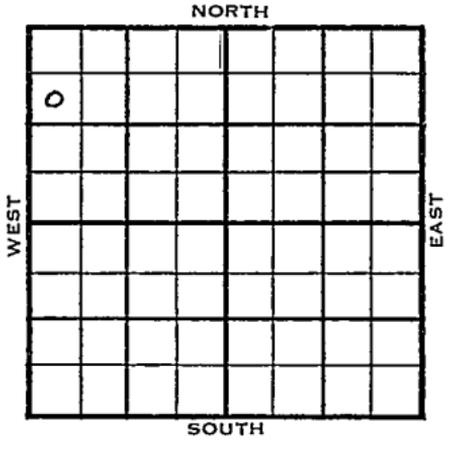

1955	ELEVATION	REPORT
	1167'	

6/1 Spud 5-25-55  
 10" @ 128 w/150  
 Drlg 2538'

6/8 Comm 5-25-55  
 Layton 2704,  
 KC 2900  
 Marm 3099  
 C 3223  
 C. Bart 3370  
 Miss 3426  
 TD 3441  
 10" @ 128/150  
 D & A

**ABANDONED**



County Cowley ✓ Elev. 1167  
 Sec. 32 Twp. 34 Rge. 3E  
 Company Texas Company  
 Farm Name L. M. Bryant "A" No. 14

TOPS	DEPTH	LOG	DATUM
Anh.			
Tp.			
H.			
Tr.			
Dg.			
BL.			
L. <u>ayton</u>	<u>2704</u>		<u>1537</u>
K.C.	<u>2900</u>		<u>1733</u>
BK&Marm	<u>3099</u>		<u>1932</u>
Ce.	<u>3223</u>		<u>2056</u>
C. <u>Bart</u>	<u>3370</u>		<u>2203</u>
M. <u>iss</u>	<u>3426</u>		<u>2259</u>
M.			
K.			
Mz.			
Mq.			
V.			
S.			
S.			
A			
R.			
Pe.			
G.			
TR.	<u>3441</u>		

Loc. in Sec. \_\_\_\_\_

SW NW NW

Geol. \_\_\_\_\_

Contr. \_\_\_\_\_

Capitt

Pool \_\_\_\_\_


ABANDONED

JUN 8 '55

Date Comm. 5-25-5510" @ 128/150

D &amp; A