


Map No. _____ Sec. 20 Twp. 28 R. 4Well No. 11 Love Farm _____Empire Company _____

NORTH

WEST

EAST

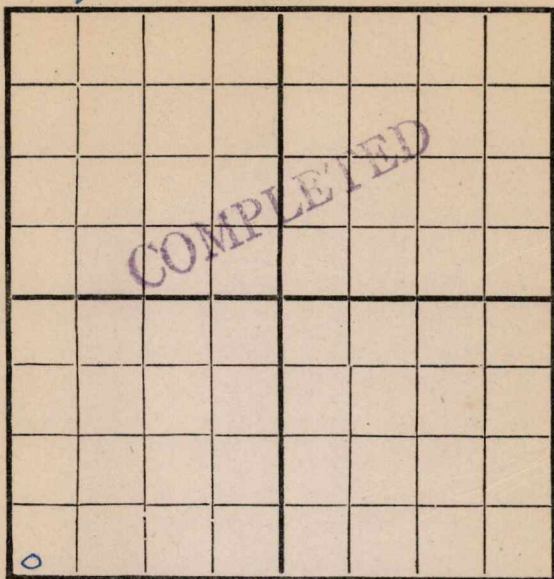

SOUTH

Location _____

Rig Up 1-22-17

Drilling Remarks:

Drilling Remarks:

RECORD

PRODUCTION

Cased _____ in _____ Ft.

1st 24 hrs. Nat. _____

Sand _____

1st 24 hrs. after shot _____

Gas _____

Gas _____ Cu. Ft.

Oil _____

Dry Hole _____

Total Depth _____


Abandoned _____

Map No. Sec. 20 Twp. 38 R. 4Well No. 11 Lore Farm
Empire Company

NORTH

WEST

EAST

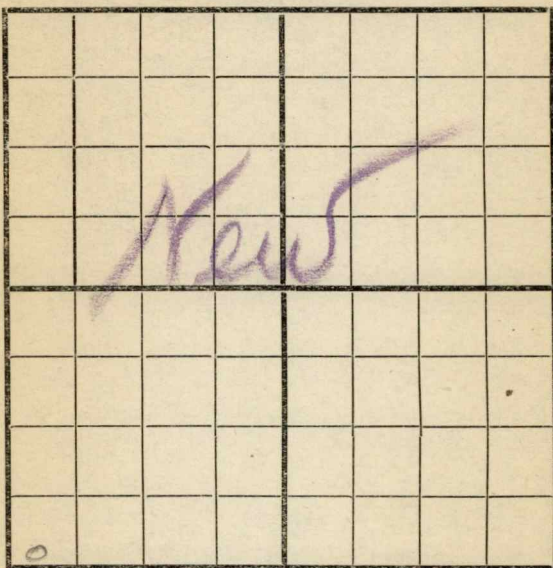

SOUTH

Location Rig Up ✓

Drilling and remarks

RECORD

Cased in. Ft.Sand Gas Oil Total Depth

PRODUCTION

1st 24 hrs. Nat. 1st 24 hrs. after shot Gas Cu. Ft.Dry Hole Abandoned

Date


1/27, 1912 C. C. C. Scout

Map No. _____ Sec. 20 Twp. 28 R. 4
 Well No. 11 Love _____ Farm
 _____ Company

NORTH

WEST

EAST

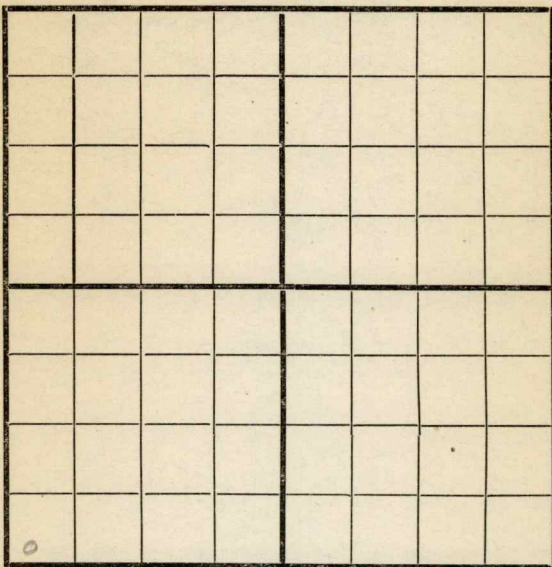

SOUTH

Location _____
 Rig Up _____
 Drilling and remarks _____

RECORD

Cased _____ in. _____ Ft.
 Sand _____
 Gas _____
 Oil _____
 Total Depth _____

PRODUCTION

1st 24 hrs. Nat. _____
 1st 24 hrs. after shot _____
 Gas _____ Cu. Ft.
 Dry Hole _____
 Abandoned _____


Date

1917, 191 _____ Scout

Map No. _____ Sec. 30 Twp. 28 R. 4Well No. 11 Love _____ Farm

_____ Company

NORTH

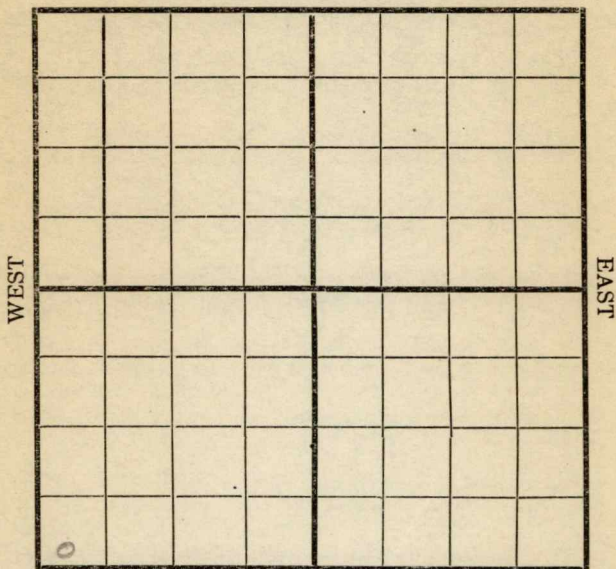

SOUTH

Location _____

Rig Up _____

Drilling and remarks

Rigging up

RECORD

Cased _____ in. _____ Ft.

Sand _____

Gas _____

Oil _____

Total Depth _____

PRODUCTION

1st 24 hrs. Nat. _____

1st 24 hrs. after shot _____

Gas _____ Cu. Ft.

Dry Hole _____

Abandoned _____

Date

2/5, 1917 W. Condit Scout

WEST

EAST

SOUTH

Location _____
Rig Up _____
Drilling and remarks _____

Cased _____ in. _____ Ft.
 Sand _____
 Gas _____
 Oil _____
 Total Depth _____

1st 24 hrs. Nat.
1st 24 hrs. after shot
Gas Cu. Ft.
Dry Hole
Abandoned

Date _____

191

Scout

Map No. _____ Sec. 20 Twp. 28 R. 4
 Well No. 11 Love _____ Farm
Empire _____ Company

NORTH

WEST

EAST

SOUTH

Location _____
 Rig Up _____
 Drilling and remarks

RECORD

Cased _____ in. _____ Ft.
 Sand _____
 Gas _____
 Oil _____
 Total Depth _____

PRODUCTION

1st 24 hrs. Nat. _____
 1st 24 hrs. after shot _____
 Gas _____ Cu. Ft.
 Dry Hole _____
 Abandoned _____

Date

191


Scout

Map No. _____ Sec. 20 Twp. 28 R. 4
 Well No. 11 Lost Farm _____
Amey Company _____

NORTH

WEST

EAST

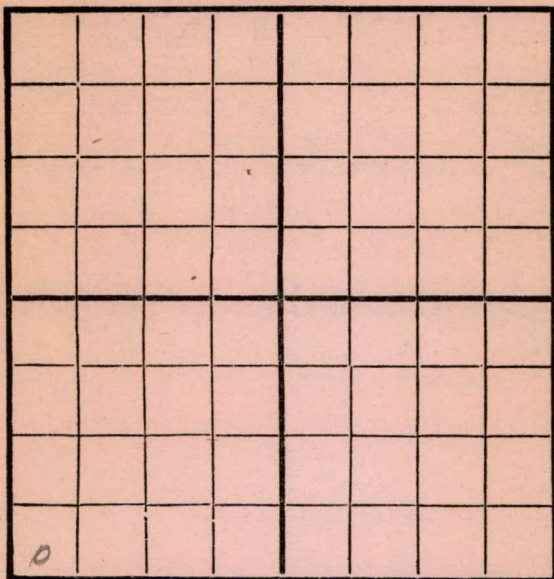

SOUTH

Location _____
 Rig Up _____
 Drilling and remarks _____

965

RECORD

Cased _____ in. _____ Ft.
 Sand _____
 Gas _____
 Oil _____
 Total Depth _____

PRODUCTION

1st 24 hrs. Nat. _____
 First 24 hrs. after shot _____
 Gas _____ Cu. Ft.
 Dry Hole _____
 Abandoned _____

Date


2/26/1917 Carly Scout

Map No. _____ Sec. 20 Twp. 28 R. 4Well No. 112 Love _____ FarmEmpire _____ Company

NORTH

WEST

EAST

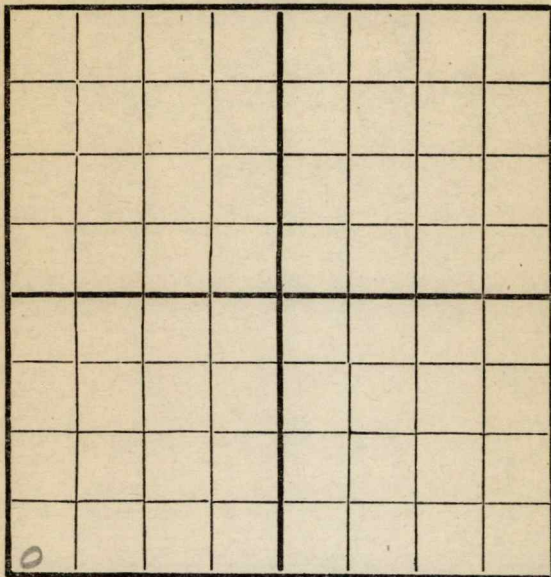

SOUTH

REMARKS:

1660

Date


3/5-7, 1917

Scout

Map No. _____ Sec. 20 Twp. 28 R. 4
Well No. 11 Love Farm _____
Empire Company _____

NORTH

WEST

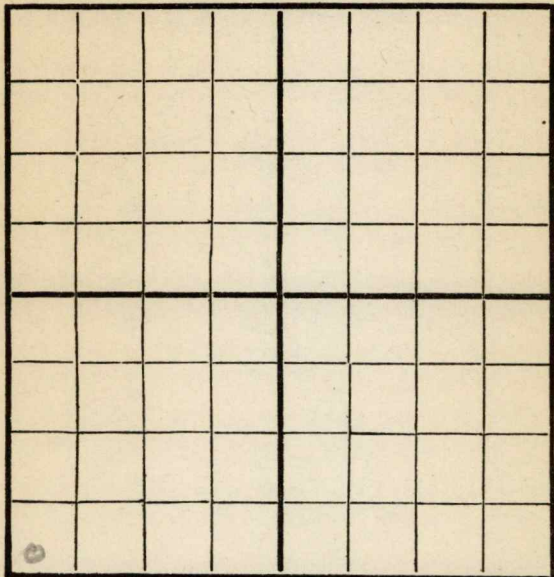

EAST

SOUTH

Location _____
Rig Up _____
Drilling and remarks _____

2200

RECORD

Cased _____ in. _____ Ft.
Sand _____
Gas _____
Oil _____
Total Depth _____

PRODUCTION

1st 24 hrs. Nat. _____
1st 24 hrs. after shot _____
Gas _____ Cu. Ft.
Dry Hole _____
Abandoned _____

Date 3/2, 1917 Empire Scout

Map No. _____ Sec. 20 Twp. 28 R. 4Well No. 4 Love Farm _____

_____ Company _____

NORTH

WEST

EAST

COMPLETED

SOUTH

Location _____

Rig Up _____

Drilling and remarks

Est at
30 Bbls

RECORD

Cased _____ in. _____ Ft.

Sand 455-2469

Gas _____

Oil _____

Total Depth _____

PRODUCTION

1st 24 hrs. Nat. _____

1st 24 hrs. after shot _____

Gas _____ Cu. Ft.

Dry Hole _____

Abandoned _____

Date

3/19, 191 7 Landoff Scout