


Section 32 Township 34 Range 3E

Well No. 4-- L.M. Bryant "B"

Company Texas Company

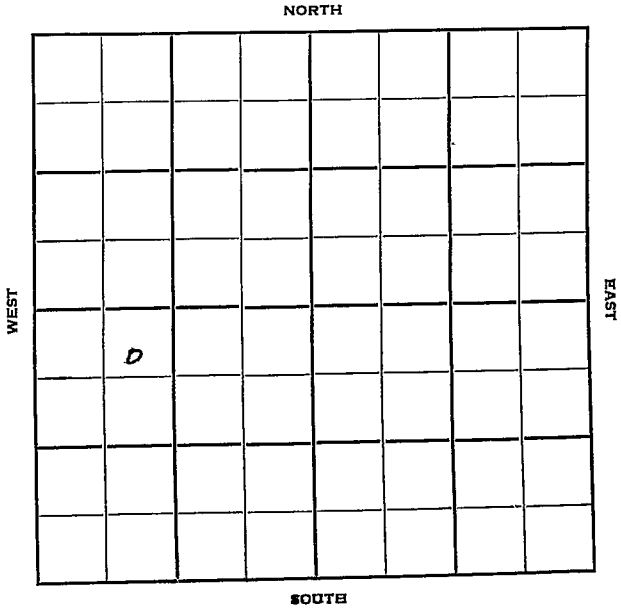

Cowley

KANSAS ✓

Sec. 32 Twp. 34 R. 3E

Well No. 4 L. M. Bryant "B" Farm

Texas Company Company

Cappit Drlg. Contractor


330 Ft. from N. Line

\_\_\_\_\_ Ft. from S. Line

\_\_\_\_\_ Ft. from E. Line

990 Ft. from W. Line

NE NW SW

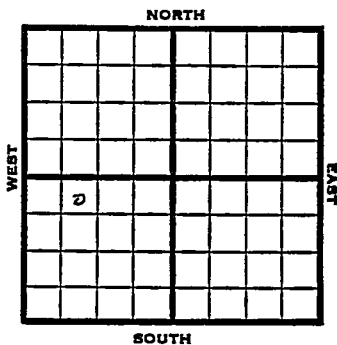

1952

Elev. 1145 REPORT

12/30

Spudding 12/28/52, 10" @ 110  
WOC

2/11

Spudding Date 12/28/52  
Oil Well TD 3408  
10" @ 110 Bart. 3396 TD 3408 7" @  
3397 CO to 3408 1 go 3 gwph st-frac  
S/8 bo  $\frac{1}{4}$ /64 bo 3 bw 22 hr.  
P/36 bo 6 bw 14 hr.  
Comp. 51 bopd 10 bw.

**COMPLETED**



