


Map No. _____ Sec. 20 Twp. 28 R. 4Well No. 13 Lone Farm __________Empire_____
Company

NORTH

WEST

EAST

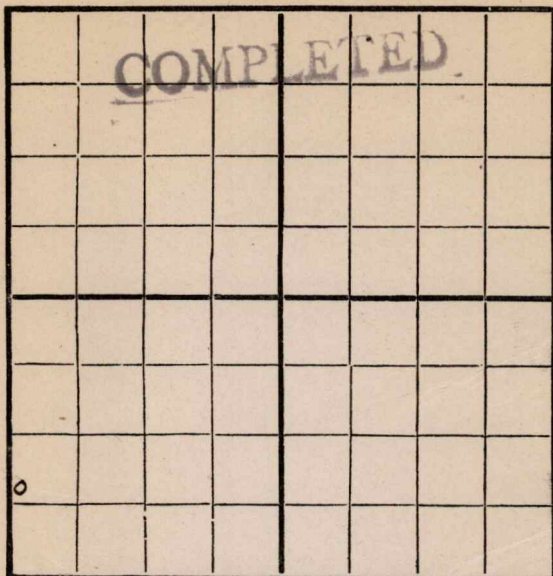

SOUTH

Location _____

Rig Up _____

Drilling Remarks:

Drilling Remarks:

RECORD

PRODUCTION

Cased _____ in _____ Ft.

1st 24 hrs. Nat. _____

Sand _____

1st 24 hrs. after shot _____

Gas _____

Gas _____ Cu. Ft.

Oil _____

Dry Hole _____

Total Depth _____


Abandoned _____

Map No. _____ Sec. 20 Twp. 28 R. 4
Well No. 13 Love _____ Farm
Empire _____ Company

NORTH

WEST

EAST

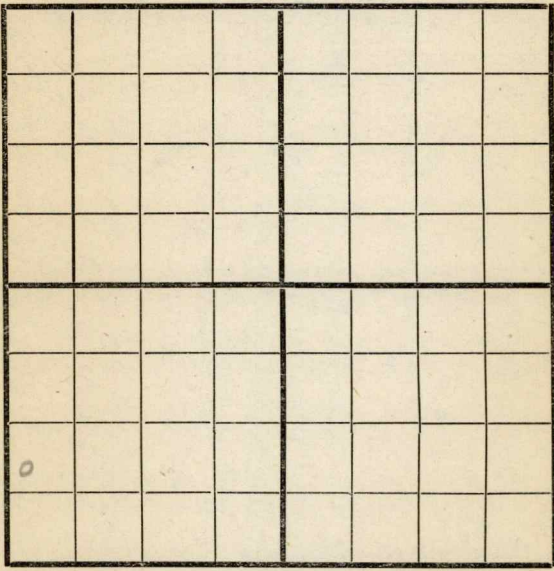

SOUTH

Location _____
Rig Up ☒ _____
Drilling and remarks _____

FIRST REPORT

RECORD

Cased _____ in. _____ Ft.
Sand _____
Gas _____
Oil _____
Total Depth _____

PRODUCTION

1st 24 hrs. Nat. _____
1st 24 hrs. after shot _____
Gas _____ Cu. Ft.
Dry Hole _____
Abandoned _____


Date 2/12, 1917 Cordiff Scout

Map No. _____ Sec. 20 Twp. 28 R. 4
 Well No. 13 _____ Farm _____
Engine _____ Company _____

NORTH

WEST

EAST

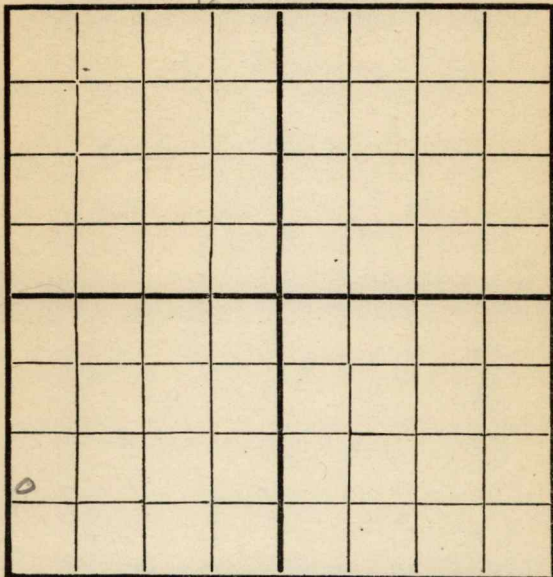

SOUTH

Location _____
 Rig Up _____
 Drilling and remarks _____

RECORD

Cased _____ in. _____ Ft.
 Sand _____
 Gas _____
 Oil _____
 Total Depth _____

PRODUCTION

1st 24 hrs. Nat. _____
 1st 24 hrs. after shot _____
 Gas _____ Cu. Ft.
 Dry Hole _____
 Abandoned _____

Date

191

Scout

Map No. _____ Sec. 20 Twp. 28 R. 4
 Well No. 13 Love Farm _____
Engine Company

NORTH

WEST

EAST

SOUTH

Location _____
 Rig Up _____
 Drilling and remarks _____

RECORD

Cased _____ in. _____ Ft.
 Sand _____
 Gas _____
 Oil _____
 Total Depth _____

PRODUCTION

1st 24 hrs. Nat. _____
 First 24 hrs. after shot _____
 Gas _____ Cu. Ft.
 Dry Hole _____
 Abandoned _____

Date


9/26 191 7 Carly Scout

Map No. _____ Sec. 20 Twp. 28 R. 4

Well No. 13 Love Farm _____

Engine Company _____

NORTH

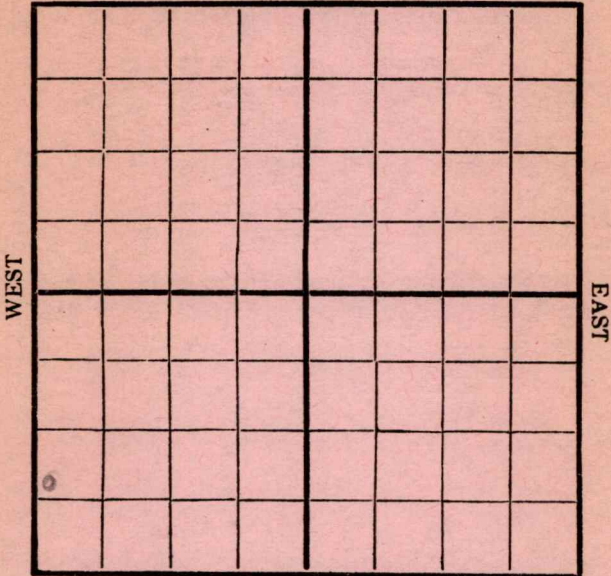

SOUTH

REMARKS:

Rig


Date 3-5-1917 Conley Scout

Map No. _____ Sec. 20 Twp. 28 R. 4
 Well No. 13 Love Farm _____
Empire Company _____

NORTH

WEST

EAST

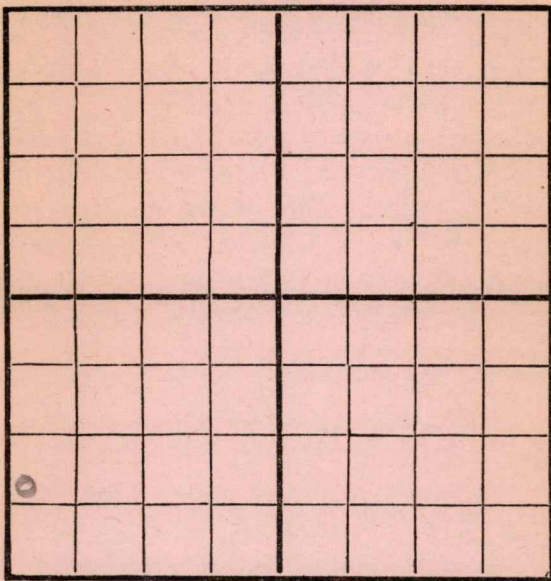

SOUTH

Location _____
 Rig Up ☒ _____
 Drilling and remarks _____

RECORD

Cased _____ in. _____ Ft.
 Sand _____
 Gas _____
 Oil _____
 Total Depth _____

PRODUCTION

1st 24 hrs. Nat. _____
 1st 24 hrs. after shot _____
 Gas _____ Cu. Ft.
 Dry Hole _____
 Abandoned _____

Date

3/2, 191

Scout

Map No. _____ Sec. 20 Twp. 28 R. 4
 Well No. 13 Lone Farm _____
Empire Company _____

NORTH

WEST

EAST

SOUTH

Location _____
 Rig Up _____
 Drilling and remarks _____

RECORD

Cased _____ in. _____ Ft.
 Sand _____
 Gas _____
 Oil _____
 Total Depth _____

PRODUCTION

1st 24 hrs. Nat. _____
 1st 24 hrs. after shot _____
 Gas _____ Cu. Ft.
 Dry Hole _____
 Abandoned _____

Date


3/19, 1917. C. Carby Scout

Map No. _____ Sec. 20 Twp. 28 R. 4
 Well No. 13 Love Farm _____
Empire Company _____

NORTH

WEST

EAST

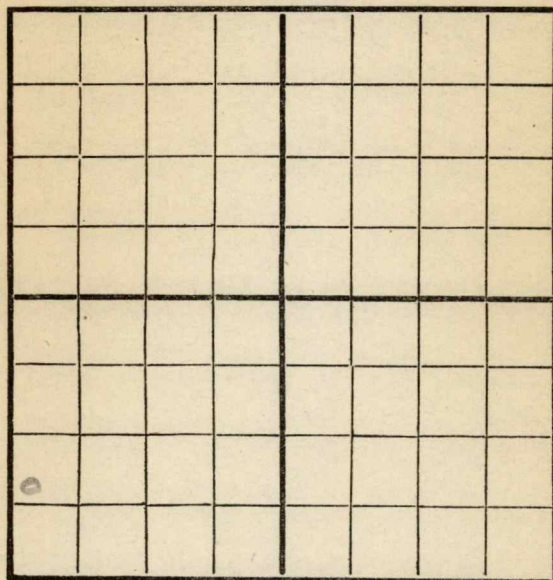

SOUTH

Location _____
 Rig Up _____
 Drilling and remarks _____

Rigging up

RECORD

Cased _____ in. _____ Ft.
 Sand _____
 Gas _____
 Oil _____
 Total Depth _____

PRODUCTION

1st 24 hrs. Nat. _____
 1st 24 hrs. after shot _____
 Gas _____ Cu. Ft.
 Dry Hole _____
 Abandoned _____


Date 3/26, 1917 C. C. C. C. Scout

Map No. _____ Sec. 20 Twp. 28 R. 4
 Well No. 13 Love Farm _____
Engine Company _____

NORTH

WEST

EAST

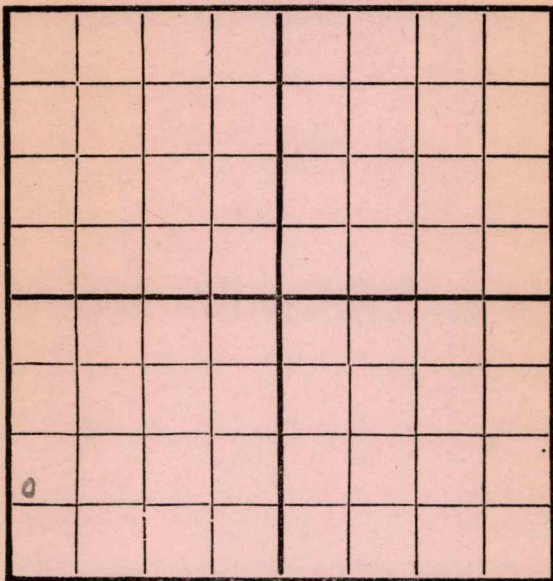

SOUTH

Location _____

Rig Up _____

Drilling and remarks

225

RECORD

Cased _____ in. _____ Ft.

Sand _____

Gas _____

Oil _____

Total Depth _____

PRODUCTION

1st 24 hrs. Nat. _____

First 24 hrs. after shot _____

Gas _____ Cu. Ft.

Dry Hole _____


Abandoned _____

Date

4/4, 191 7 Condy Scout

Map No. _____ Sec. 20 Twp. 28 R. 4
 Well No. 13 Love _____ Farm
Engine _____ Company

NORTH

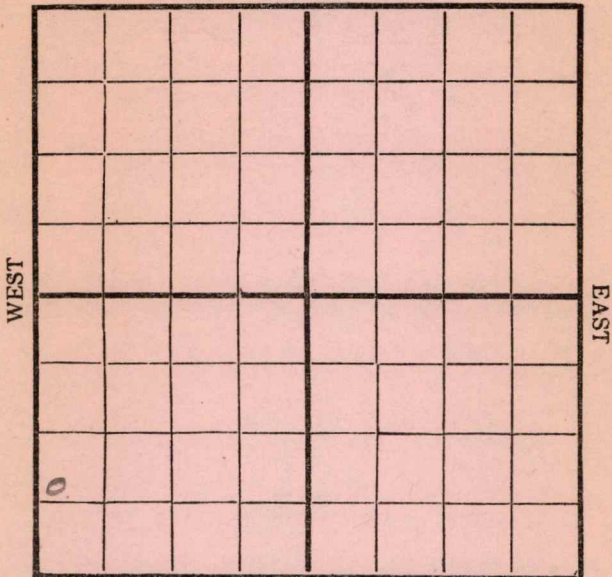

SOUTH

Location _____

Rig Up _____

Drilling and remarks

465

RECORD

Cased _____ in. _____ Ft.

Sand _____

Gas _____

Oil _____

Total Depth _____

PRODUCTION

1st 24 hrs. Nat. _____

1st 24 hrs. after shot _____

Gas _____ Cu. Ft.

Dry Hole _____


Abandoned _____

Date

4/10, 1917 Condy Scout

Map No. _____ Sec. 20 Twp. 28 R. 4
 Well No. 13 Lane Farm _____
Engine Company _____

NORTH

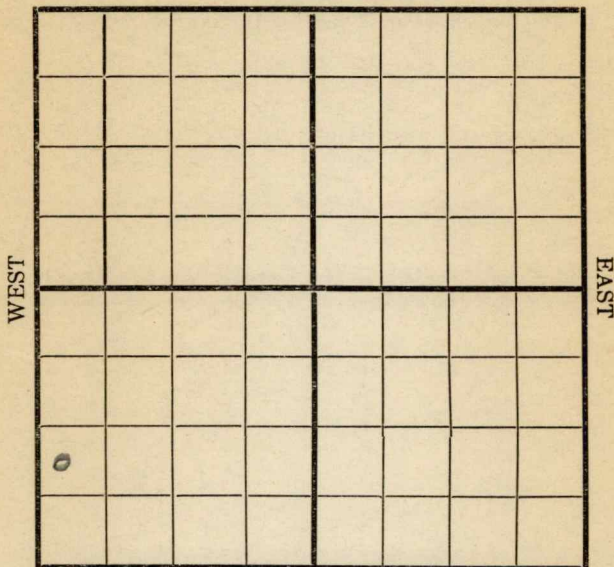

SOUTH

Location _____
 Rig Up _____
 Drilling and remarks

785'

RECORD

Cased _____ in. _____ Ft.
 Sand _____
 Gas _____
 Oil _____
 Total Depth _____


PRODUCTION

1st 24 hrs. Nat. _____
 1st 24 hrs. after shot _____
 Gas _____ Cu. Ft.
 Dry Hole _____
 Abandoned _____

Date 4/17, 1917 Conley Scout _____

Map No. _____ Sec. 20 Twp. 28 R. 4
Well No. 13 _____ Farm _____
Empire _____ Company _____

NORTH

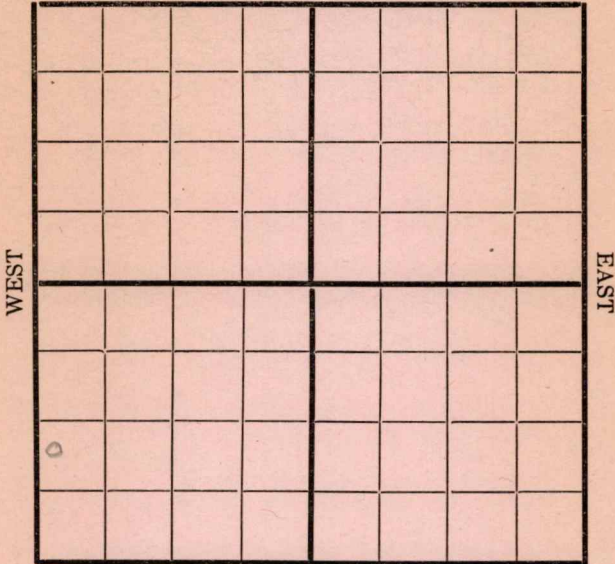


SOUTH

Location _____ Rig Up _____ Drilling and remarks <u>1880'</u>	RECORD
	Cased _____ in. _____ Ft.
	Sand _____
	Gas _____
	Oil _____
	Total Depth _____
	PRODUCTION
	1st 24 hrs. Nat. _____
	1st 24 hrs. after shot _____
	Gas _____ Cu. Ft.
	Dry Hole _____
	Abandoned _____

Date 3/2, 1912 _____ Scout _____

Map No. _____ Sec. 20 Twp. 28 R. 4
 Well No. 13 Love Farm _____
Engine Company _____

NORTH

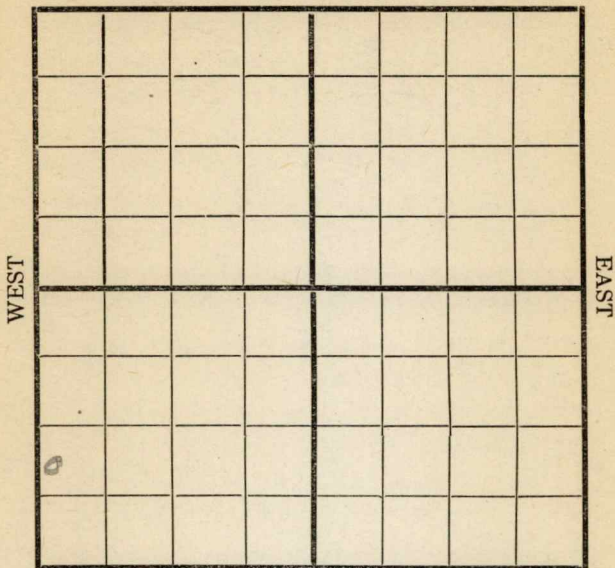

SOUTH

Location _____

Rig Up _____

Drilling and remarks

2175

RECORD

Cased _____ in. _____ Ft.

Sand _____

Gas _____

Oil _____

Total Depth _____

PRODUCTION

1st 24 hrs. Nat. _____

1st 24 hrs. after shot _____

Gas _____ Cu. Ft.

Dry Hole _____

Abandoned _____

Date


3/8, 1917 Cooley Scout

Map No. _____ Sec. 20 Twp. 28 R. 4
 Well No. 13 _____ Farm _____
Empire _____ Company _____

NORTH

WEST

EAST

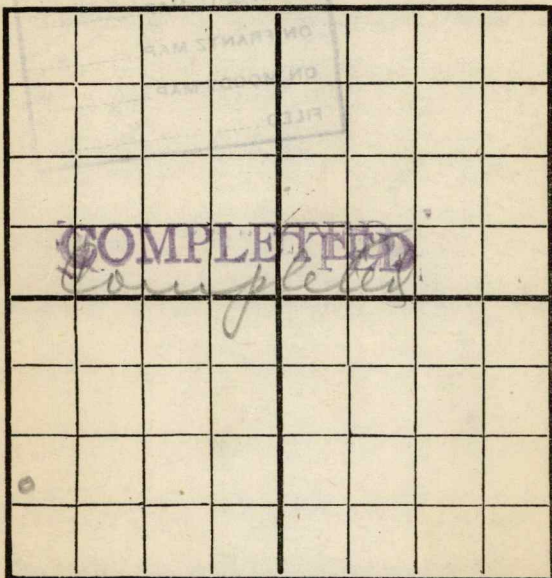

SOUTH

Location _____

Rig Up _____

Drilling and remarks

Est at
75 Bbls

RECORD

Cased _____ in. _____ Ft.

Sand 2464-2509

Gas _____

Oil _____

Total Depth _____

PRODUCTION

1st 24 hrs. Nat. _____

1st 24 hrs. after shot _____

Gas _____ Cu. Ft.

Dry Hole _____

Abandoned _____

Date

5/25, 191 7 Cordell Scout