

Map No. _____ Sec. 20 Twp. 28 R. 4Well No. 14 Love Farm __________ Empire Company _____

NORTH

WEST

EAST

SOUTH

COMPLETED

Location _____

Rig Up _____

Drilling Remarks:

Drilling Remarks:

RECORD

Cased _____ in _____ Ft.

Sand _____

Gas _____

Oil _____

Total Depth _____

PRODUCTION

1st 24 hrs. Nat. _____

1st 24 hrs. after shot _____

Gas _____ Cu. Ft.

Dry Hole _____

Abandoned _____

WEST

EAST

SOUTH

Cased _____ in. _____ Ft.
 Sand _____
 Gas _____
 Oil _____
 Total Depth _____

1st 24 hrs. Nat.-----
1st 24 hrs. after shot-----
Gas----- Cu. Ft.
Dry Hole-----
Abandoned-----

Date 2/12 1917 Conrad Scout

Map No. _____ Sec. 20 Twp. 38 R. 4
 Well No. 14 Rose _____ Farm _____
Empire _____ Company _____

NORTH

WEST

EAST

SOUTH

Location _____
 Rig Up ☒ _____
 Drilling and remarks _____

RECORD

Cased _____ in. _____ Ft.
 Sand _____
 Gas _____
 Oil _____
 Total Depth _____

PRODUCTION

1st 24 hrs. Nat. _____
 1st 24 hrs. after shot _____
 Gas _____ Cu. Ft.
 Dry Hole _____
 Abandoned _____

Date

191

Scout

Map No. _____ Sec. 20 Twp. 28 R. 4Well No. 14 Lone _____ Farm __________ Cumprine _____ Company _____

NORTH

WEST

EAST

SOUTH

Location _____

Rig Up _____ ☒

Drilling and remarks _____

RECORD

Cased _____ in. _____ Ft.

Sand _____

Gas _____

Oil _____

Total Depth _____

PRODUCTION

1st 24 hrs. Nat. _____

First 24 hrs. after shot _____

Gas _____ Cu. Ft.

Dry Hole _____

Abandoned _____


Date _____

191

Scout

Map No. _____ Sec. 20 Twp. 28 R. 4Well No. 14 Love Farm _____Empire Company _____

NORTH

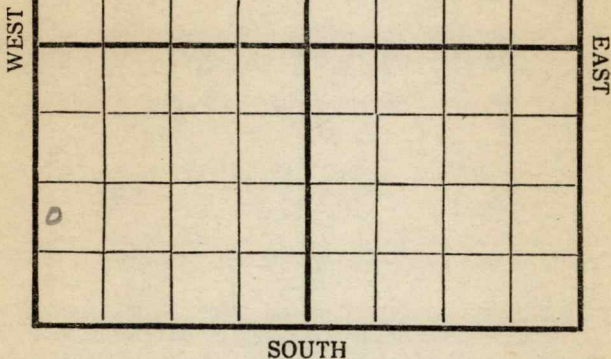

REMARKS:

Rig

Date

3/5, 1917 Cordell Scout

Map No. _____ Sec. 20 Twp. 28 R. 4
 Well No. 14 Love _____ Farm
Empire _____ Company

NORTH

WEST

EAST

SOUTH

Location _____

Rig Up _____

Drilling and remarks

*Rigging
up*

RECORD

Cased _____ in. _____ Ft.

Sand _____

Gas _____

Oil _____

Total Depth _____

PRODUCTION

1st 24 hrs. Nat. _____

1st 24 hrs. after shot _____

Gas _____ Cu. Ft.

Dry Hole _____

Abandoned _____

Date

3/12, 1917 C. C. C. Scout

Map No. _____ Sec. 20 Twp. 28 R. 4Well No. 1420 Farm _____

_____ Company _____

NORTH

WEST

EAST

SOUTH

Location _____

Rig Up _____

Drilling and remarks

375

RECORD

Cased _____ in. _____ Ft.

Sand _____

Gas _____

Oil _____

Total Depth _____

PRODUCTION

1st 24 hrs. Nat. _____

1st 24 hrs. after shot _____

Gas _____ Cu. Ft.

Dry Hole _____

Abandoned _____

Date

3/19


191

7

Scout

Map No. _____ Sec. 20 Twp. 38 R. 4
Well No. 14 Rose Farm _____
Engine Company _____

NORTH

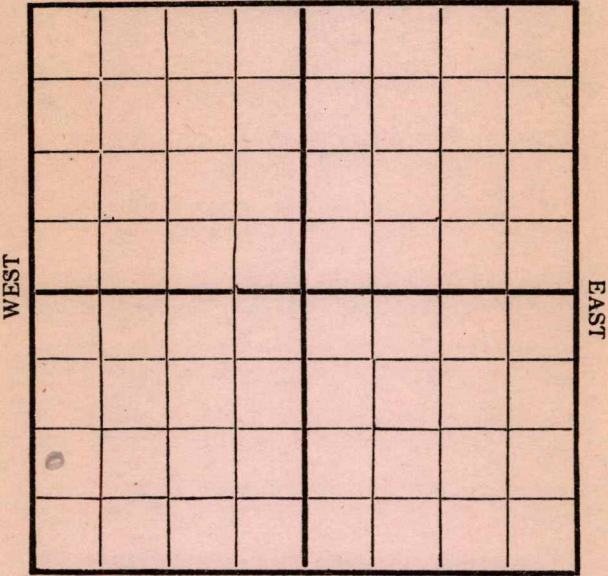

SOUTH

Location _____
Rig Up _____
Drilling and remarks _____

625'

RECORD

Cased _____ in. _____ Ft.
Sand _____
Gas _____
Oil _____
Total Depth _____

PRODUCTION

1st 24 hrs. Nat. _____
1st 24 hrs. after shot _____
Gas _____ Cu. Ft.
Dry Hole _____
Abandoned _____

Date 3/26, 1917 C. C. C. C. Scout

Map No. _____ Sec. 20 Twp. 28 R. 4Well No. 14 Love Farm _____Angene Company _____

NORTH

WEST

EAST

SOUTH

Location _____

Rig Up _____

Drilling and remarks

785

RECORD

Cased _____ in. _____ Ft.

Sand _____

Gas _____

Oil _____

Total Depth _____

PRODUCTION

1st 24 hrs. Nat. _____

First 24 hrs. after shot _____

Gas _____ Cu. Ft.

Dry Hole _____

Abandoned _____

Date


4/4, 191 7 Carly Scout

Map No. _____ Sec. 20 Twp. 28 R. 4
 Well No. 14 Love Farm _____
Empire Company _____

NORTH

WEST

EAST

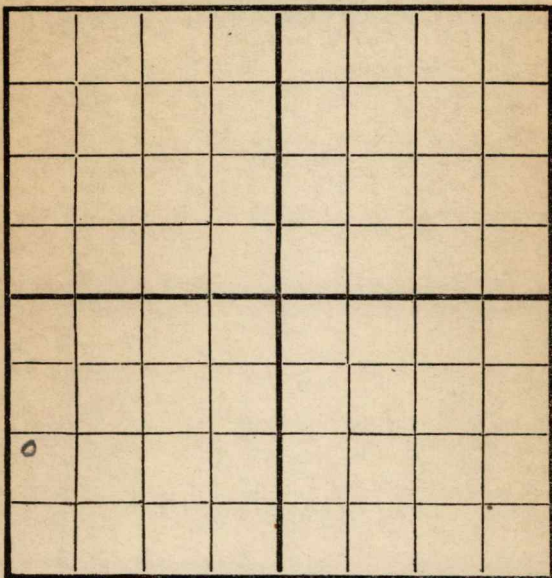

SOUTH

Location _____
 Rig Up _____
 Drilling and remarks

1340'

RECORD

Cased _____ in. _____ Ft.
 Sand _____
 Gas _____
 Oil _____
 Total Depth _____

PRODUCTION

1st 24 hrs. Nat. _____
 1st 24 hrs. after shot _____
 Gas _____ Cu. Ft.
 Dry Hole _____
 Abandoned _____

Date

4/10,

191

7 Conley

Scout

Map No. _____ Sec. 20 Twp. 28 R. 4Well No. 14 Love _____ FarmCummins _____ Company

NORTH

WEST

EAST

SOUTH

Location _____

Rig Up _____

Drilling and remarks

1810'

RECORD

Cased _____ in. _____ Ft.

Sand _____

Gas _____

Oil _____

Total Depth _____

PRODUCTION

1st 24 hrs. Nat. _____

1st 24 hrs. after shot _____

Gas _____ Cu. Ft.

Dry Hole _____


Abandoned _____

Date

4/17, 1917 Candy Scout

Map No. _____ Sec. 20 Twp. 28 R. 4
 Well No. 14 Lone Farm _____
Engine Company _____

NORTH

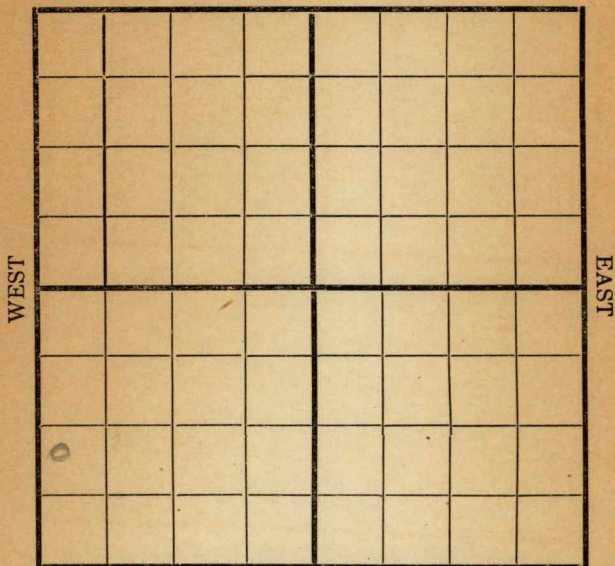

SOUTH

Location _____
 Rig Up _____
 Drilling and remarks _____

2185

RECORD

Cased _____ in. _____ Ft.
 Sand _____
 Gas _____
 Oil _____
 Total Depth _____

PRODUCTION

1st 24 hrs. Nat. _____
 1st 24 hrs. after shot _____
 Gas _____ Cu. Ft.
 Dry Hole _____
 Abandoned _____

Date

4/24, 191 2 _____ Scout

Map No. _____ Sec. 20 Twp. 28 R 4Well No 14 Lone _____ Farm _____

_____ Company _____

NORTH

WEST

EAST

SOUTH

Location _____

Rig Up _____

Drilling and remarks

Tap sand2445

RECORD

Cased _____ in. _____ Ft.

Sand _____

Gas _____

Oil _____

Total Depth _____

PRODUCTION

1st 24 hrs. Nat. _____

1st 24 hrs. after shot _____

Gas _____ Cu. Ft.

Dry Hole _____

Abandoned _____

Date

5/2, 1912 Carby Scout

Map No. _____ Sec. 20 Twp. 28 R. 4
 Well No. 14. Love Farm _____
Engine Company _____

NORTH

WEST

COMPLETED

EAST

SOUTH

Location _____

Rig Up _____

Drilling and remarks

Estimated
75 Bbls

RECORD

Cased _____ in. _____ Ft.

Sand 2445-2488

Gas _____

Oil _____

Total Depth _____

PRODUCTION

1st 24 hrs. Nat. _____

1st 24 hrs. after shot _____

Gas _____ Cu. Ft.

Dry Hole _____

Abandoned _____

Date

5/8, 1917 Cordiff Scout