

WEST

EAST

SOUTH

Rig Up -----

Drilling Remarks:

PRODUCTION

1st 24 hrs. Nat.-----

1st 24 hrs. after shot-----

Gas _____ cu. ft.

Dry Hole -----

Abandoned -----

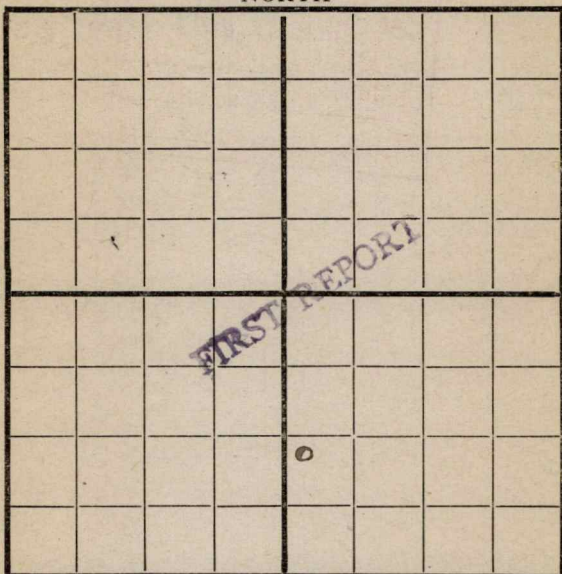
Map No. K11 Sec. 20 Twp. 28 R. 4Well No. 22 LoveEmpire Company

Contractor

NORTH

WEST

EAST

260 W

SOUTH

1060 S

Location _____

Rig up _____

Drilling and Remarks:

Rigging up

RECORD

Cased _____ in., _____ ft.

Sand _____

Gas _____

Oil _____

Total Depth _____

PRODUCTION

1st 24 hrs. Nat. _____

1st 24 hrs. after shot _____

Gas _____ Cu. Ft.

Dry Hole _____

Abandoned _____

Date

4/231919Pyle

Scout

Map No. K11 Sec. 20 Twp. 28 R. 4Well No. 22 LoveEmpire Company

Contractor

SECTION PLAT

Ft. from N. Line

1120 Ft. from S. Line

Ft. from E. Line

260 Ft. from W. Line

		0	

Location

Rig up

Drilling and Remarks:

65 bbls
1st 12 hrs
Pumped off

RECORD

Cased _____ in., _____ ft.

Sand 2483-2494

Gas _____

Oil _____

Total Depth _____

PRODUCTION

1st 24 hrs. Nat. _____

1st 24 hrs. after shot _____

Gas _____ Cu. Ft.

Dry Hole _____

Abandoned _____

Date

9/19 1919

Pyle

Scout