



Butler

KANSAS



Sec. 20 Twp. 28 R. 4E

Well No. #1 Smith Farm

Thrifty Drlg. Company

Miscellaneous


990' Ft. from N. Line

Ft. from S. Line

Ft. from E. Line

330' Ft. from W. Line

NW SW NW

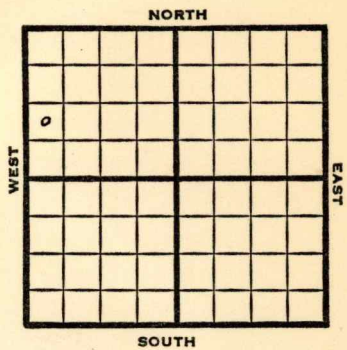

1949

Elev 1275' REPORT

6/15

8" @ 60'  
Drlg. 400'

6/21

Lansing 1795'  
KC 2035'  
Arbuckle 2476'  
TD 2478'

6/29

5" @ 2477'  
TD 2483'  
Arb. 2476'  
5" @ 2477'  
Pump 50 Oil Pht  
38° Gr.  
Comp

COMPLETED

Butler County Kansas State

Map No. \_\_\_\_\_ Sec. 20 Twp. 28 R. 4E

Well No. 1 Smith

Thrifty Drlg. Company

\_\_\_\_\_ Contractor  
NW SW NW

FIRST REPORT  
SECTION PLAT

\_\_\_\_\_ Ft. from N. Line

990 Ft. from S. Line


\_\_\_\_\_ Ft. from E. Line

330 Ft. from W. Line


Miscellaneous

Remarks:

8" @ 80 drlg. 400

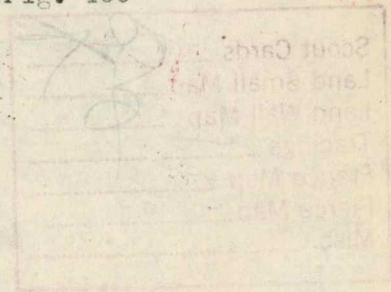

Date  
JUN 15 1949

Scout S. J. LEWIS

Map No. K11 Sec. 20 Twp. 28 R. 4E

Well No. 1 Smith

Thrifty Drlg. Company

**COMPLETE** Contractor

NW SW NW

E11225  
SECTION PLAT

o			

\_\_\_\_\_ Ft. from N. Line

990 Ft. from S. Line

\_\_\_\_\_ Ft. from E. Line

330 Ft. from W. Line

Butler County

Location \_\_\_\_\_

Rig up \_\_\_\_\_

Drilling and Remarks:

Ar 2476

5' @ 2477

Pump 50 oil

380-44

RECORD

Cased \_\_\_\_\_ in., \_\_\_\_\_ ft.

Sand \_\_\_\_\_

Gas \_\_\_\_\_

Oil \_\_\_\_\_

Total Depth 2483

PRODUCTION

1st 24 hrs. Nat. \_\_\_\_\_

1st 24 hrs. after shot \_\_\_\_\_

Gas \_\_\_\_\_ Cu. Ft.

Dry Hole \_\_\_\_\_

Abandoned \_\_\_\_\_

Date

JUN 29 1949 19

S. J. LEWIS Scout