



Cowley

KANSAS


SEC.	TWP.	R.
32	34	3 E

WELL NO. # 13 L. M. Bryant "C" FARM

COMPANY Texas Company

CONTRACTOR Capitt

\_\_\_\_\_ Ft. from N. Line  
 \_\_\_\_\_ Ft. from S. Line  
 \_\_\_\_\_ Ft. from E. Line  
 \_\_\_\_\_ Ft. from W. Line

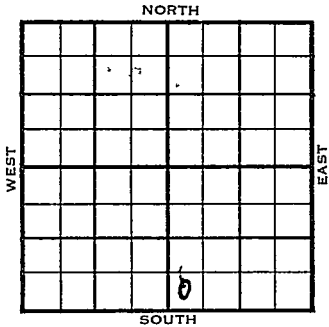

SW SW SE

	ELEVATION	REPORT
1955	1167'	

6/22 10" @ 129 7" @ 3810 CO to 3816  
 FU 3100' SW CO to 3816 S/30 B 1d  
 wtr. S/4 BO 200 BW 8 hr. PB 3813  
 1/2 BOPH 2 hr. 9/3809-11 20 G<sup>OPH</sup>  
 6 hr. 2500 A S/18 BO 11 BW 5 hr.  
 Comp. 95 BOPD 72 BW  
 TOPS: Layton 2693', A. 3809'  
 LOG: Layton 2685', KC 2880',  
 M. 3425', S. 3738', Sd 3774',  
 A. 3809'  
 TD 3816'

**FIRST REPORT**  
 COMPLETED

County Cowley ✓ Elev. 1167  
 Sec. 32 Twp. 34 Rgs. 3E  
 Company Texas Company  
 FarmName L. M. Bryant "C" No. 13

TOPS	DEPTH	LOG	DATUM	Loc. in Sec.
Anh.				SW SW SE
Tp.				
H.				
Tr.				
Dg.				
Bl.				
L. <u>ayten</u>	<u>2693</u>	<u>2685</u>	<u>1518</u>	Geol.
K.C.		<u>2880</u>	<u>1713</u>	
B.K.C.				Contr.
Ce.				
C.				Capitt
M.		<u>3425</u>	<u>2258</u>	Pool
M.				
K.				Gibson
Mz.				
Me.				
V.				
S.		<u>3738</u>	<u>2571</u>	COMPLETE FIRST REPORT
S. <u>sd</u>		<u>3774</u>	<u>2667</u>	
A	<u>3809</u>	<u>3809</u>	<u>2642</u>	
R.				
Pe.				
G.				
T.D.	<u>3816</u>			0

Date Comm. JUN 22 1975  
 10" @ 129 7" @ 3810 CO to 3816  
 FU 3100' sw CO to 3816 .S/ 30 b ld wtr  
 S/ 4 bo 200 bw 8 hr. PB 3813  
 1/2 boph 2 hr. 9/ 3809-11 20 goph  
 6 hr. 2500 A S/ 18 bo 11 bw 5 hr.  
 Comp. 95 bopd 72 bw

Co.  
Lse.  
No.  
Sec.  
T.  
R.