

Map No. K11 Sec. 20 Twp. 28 R. 4

Well No. 23 Love


Empire Company

Contractor

NORTH

WEST

EAST

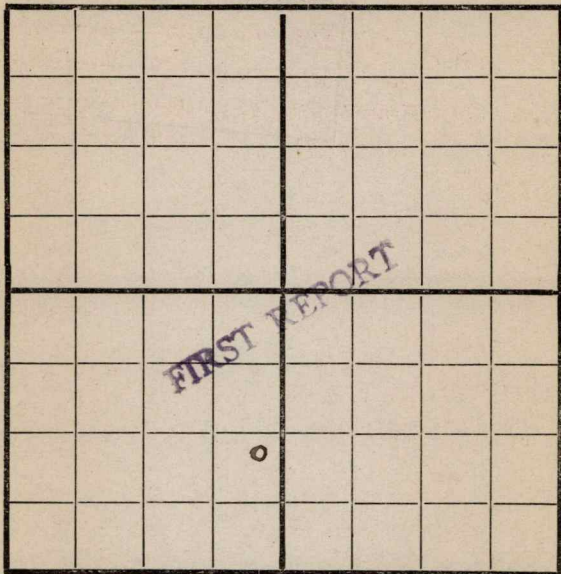

260 E

SOUTH

10605

Location _____

Rig up

Drilling and Remarks:

RECORD

Cased _____ in., _____ ft.

Sand _____

Gas _____

Oil _____

Total Depth _____

PRODUCTION

1st 24 hrs. Nat. _____

1st 24 hrs. after shot _____

Gas _____ Cu. Ft.

Dry Hole _____

Abandoned _____

Date

4/23

1919

Pyle

Scout


Map No. K11 Sec. 20 Twp. 28 R. 4

Well No. 23 Love

Empire Company

Contractor

NORTH

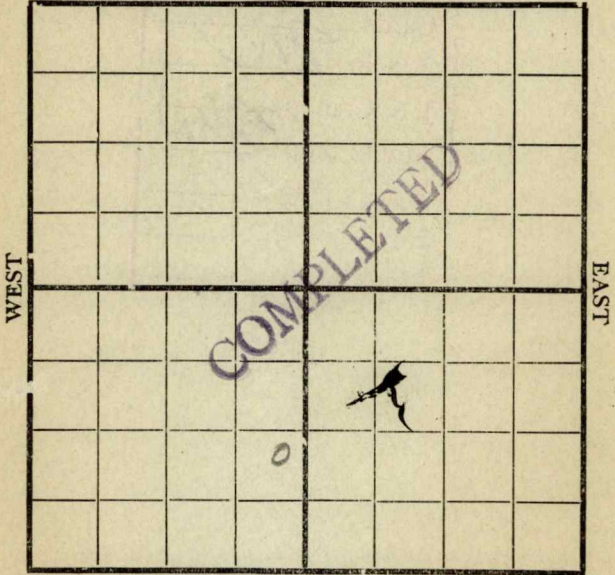

260 N.E SOUTH

Location 1120'S

Rig up

Drilling and Remarks:

RECORD

Cased _____ in., _____ ft.

Sand 1765-1770

Gas _____

Oil _____

Total Depth _____

PRODUCTION

1st 24 hrs. Nat. 30 bbls

1st 24 hrs. after shot _____

Gas _____ Cu. Ft.

Dry Hole _____

Abandoned _____

Date

8/6 1919 Pyle Scout