


Section 32 Township 34 Range 3E

Well No. #2 J. M. Bryant C'

Company Texas Co.

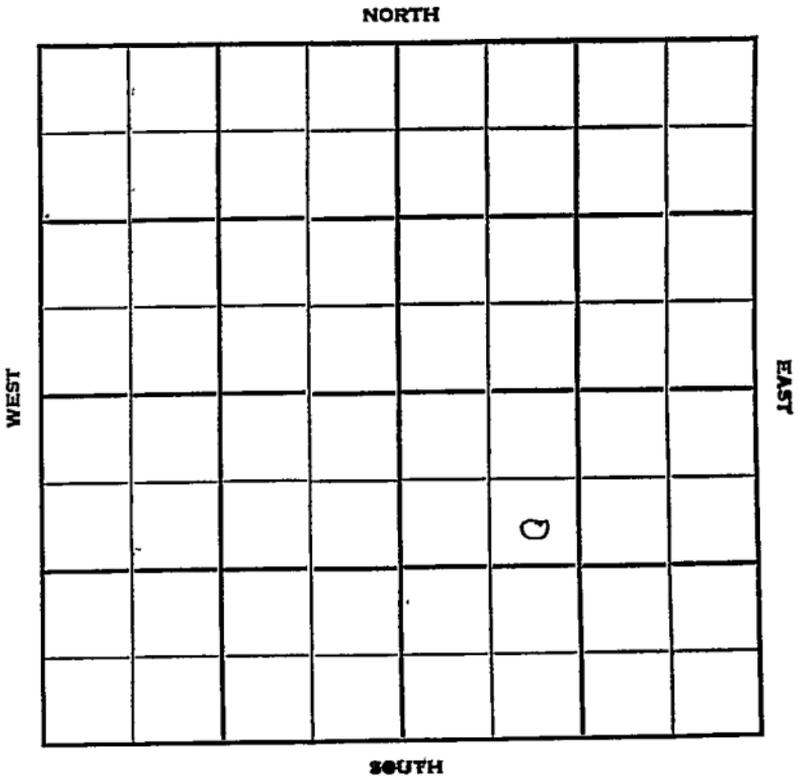

Sec. 32 Twp. 34 R. 3E

Well No. #2 L. M. Bryant "C" Farm

Texas Co. Company

Morrison Drlg. Contractor


990 Ft. from N. Line

Ft. from S. Line

Ft. from E. Line

990 Ft. from W. Line

SE NW SE

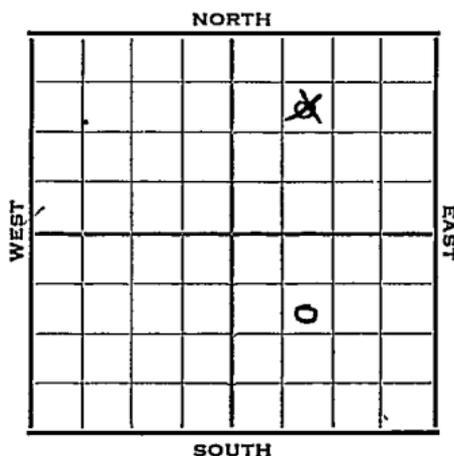

1952 Elev. 1150' REPORT

5/14 Spud 5-12-52
10" @ 127' WOC

6/25 Spud 5-12-52
Oil Well TD 3434
10" @ 127
Bart 3372 Miss 3398
TD 3434 7" @ 3432 Co to 3423
24/3384-90 FU 115' oil 4 hr.
Hydro S/113 bo 26 bw 14 hr.
Comp. 64 bopd 2½ bw
COMPLETED

