


Map No. Kans Sec. 20 Twp. 28 R. 4
 Well No. 92 Love Farm
Empire G & H Company
 NORTH

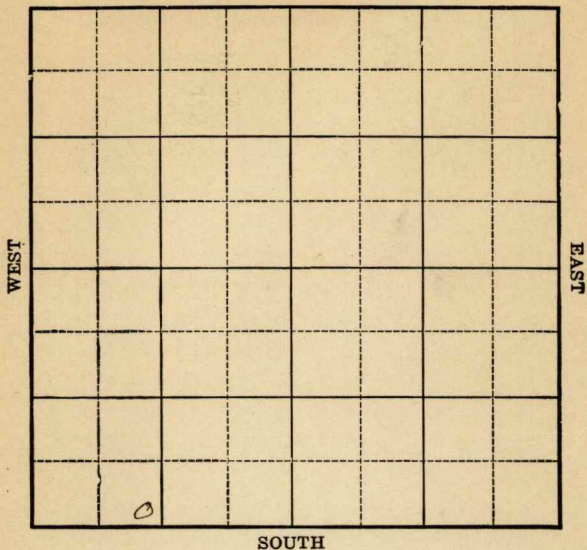

Location _____
 Drilling Remarks _____

Rig Up _____
 Drilling Remarks _____

RECORD

Cased _____ in. _____ ft.
 Sand _____
 Gas _____
 Oil _____
 Total Depth _____

PRODUCTION

1st 24 hrs. Nat. _____
 1st 24 hrs. after shot _____
 Gas _____ cu. ft.
 Dry Hole _____
 Abandoned _____


Butler

Map No. 17th Sec. 20 Twp. 28 R. 4Well No. 32 Love FarmEmpire G & Fuel Company

Ft. from N. Line

200 Ft. from S. Line

Ft. from E. Line

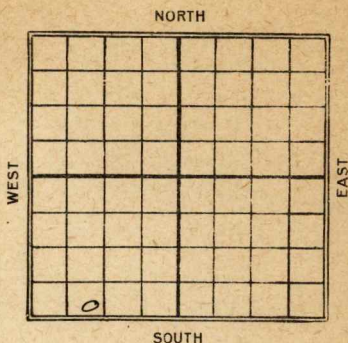1120 Ft. from W. Line

1926

Date

REPORT

Date	REPORT
9/29	Only 800'
10/13	" 1285'
10/27	" 2210'
11/11	Sand 2473-2478
	30 bbls oil 30 bbls wat.

11 **KANSAS** 20 28 4
 Map No. Sec. Twp. R.

Well No. 32
 Empire Oil & Gas Co. Company

Contractor

FIRST REPORTS

Ft. from N. Line

200

Ft. from S. Line

Ft. from E. Line

1120

Ft. from W. Line

SECTION PLAT

Location

Rig up

Drilling and Remarks:

Drill 800'

RECORD

Cased in, ft.

Sand

Gas

Oil

Total Depth

PRODUCTION

1st 24 hrs. Nat.

1st 24 hrs. after shot

Gas Cu. Ft.

Dry Hole

Abandoned

Date

SEP 29 1926 **CHAS. L. SHERWOOD**

192

Scout

Butler
 11 KANSAS 20 28 R. 4
 Map No. Sec. Twp. R.
 Well No. 32 Lower
 63 pvc Set Company

Contractor

COMPLETED

SECTION PLAT

o			

Ft. from N. Line

200 Ft. from S. Line

Ft. from E. Line

1120 Ft. from W. Line

Location

Rig up

Drilling and Remarks:

30 bbls oil

30 bbls water

RECORD

Cased in., ft.

Sand 2473-2478

Gas

Oil

Total Depth 2478

PRODUCTION

1st 24 hrs. Nat.

1st 24 hrs. after shot

Gas Cu. Ft.

Dry Hole

Abandoned

Date

NOV 11 1926

CHAS. L. SHERWOOD

1926

Scout