


Section 32 Township 34S Range 3E

Well No. #10 L.M. Bryant "C"

Company Texas Co.

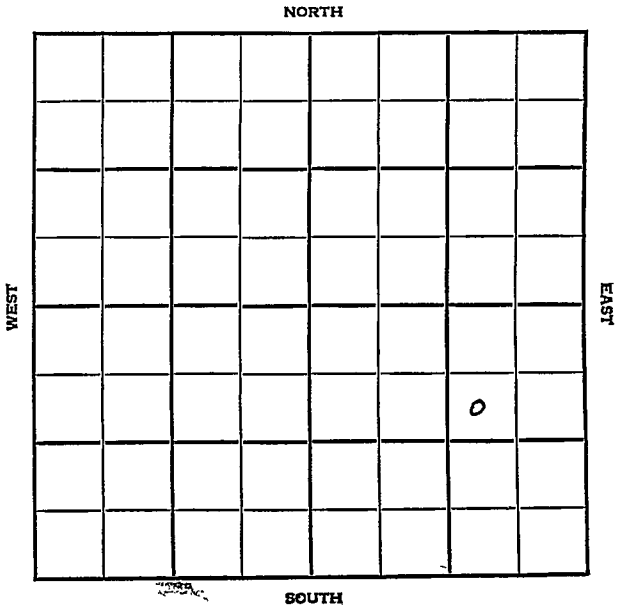

Cowley KANSAS

SEC.	TWP.	R.
32	3 4S	3E

WELL NO. **10 L. M. Bryant "C"** FARM

COMPANY **Texas Co.**


CONTRACTOR **Capitt
Gibson**

990 _____ Ft. from N. Line

_____ Ft. from S. Line

990 _____ Ft. from E. Line

_____ Ft. from W. Line

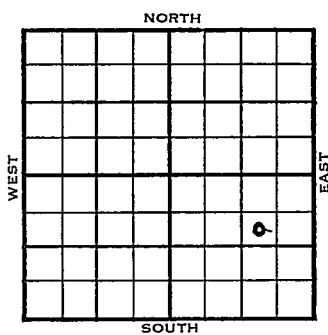

SW NE SE

	ELEVATION	REPORT
1954	1156'	

12/8 Spud 12-4-54
10" @ 129'
Drig. 1390'

1955
2/2 Spud 12-4-54 Oil well TD 3800
10" @ 129 Iatan 2204', Stal. 2229'
Layton 2664', KC 2861', Marm 3065'
Cherokee 3182', Bart 3325', Bart sd.
3365', Miss. 3406 TD 3798
Simp. 3758 Arb. 3795 DD 3800
S/80 BO 5 hr. 300 A F/191 BO 12 hr.
Comp. 191 BOPD

COMPLETED

