

KANSAS

Section 32 Township 34 Range 3E

Well No. #11 L.M. Bryant "C"

Company Texas Company

NORTH

WEST

EAST

SOUTH

0

SEC.	TWP.	R.
32	34	3E

WELL NO.

#11 L.M. Bryant "C"

FARM

COMPANY

Texas Company

CONTRACTOR

Capitt

Gibson Pool

Ft. from N. Line


330

Ft. from S. Line

990

Ft. from E. Line

Ft. from W. Line

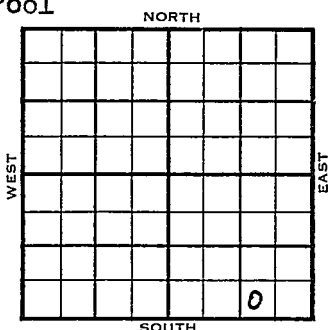

SW SE SE

ELEVATION

REPORT

1955

3/2

Spud 2-25-55

10" @ 128'

Drlg. 1835'

4/13

Spud 2-25-55 Oil well TD 3815

10" @ 128 Haskell 2209 Stal. 2255

Layton 2671 KC 2901 Marm 3072

Cherokee 3190 Peru 3193

DST 2997-3040 open 1 hr rec 15' GCM

54# Skinner 3248 Bart 3393

Miss 3412 Simp. 3736 Simp. sd. 3769

Arb. 3808 TD 3815 7" @ 3807

GO to 3815 300 A F/24 BO 6 hr.

F/103 BOPD F/13 BO 2 hr.

Comp. 68 BOPD

COMPLETED

County **Cowley** State **Kansas**

Sec. **32** (Blk. Twp.) **34** (Sur. Rge.) **3E** Map No.

Operator Texas Company

Well No. 11 Farm L. M. Bryant "C"

Elev.	Location	SW	SE	SE
-------	----------	----	----	----

330 Ft. From S Line SE

990 Ft. From E Line Quarter

1st. Report MAR 2 1955

Completion

Remarks

Capitt - Contr.


Spudding Date 2-25-55

Drlg. Data Gibson Pool

10ⁿ @ 128 drlg. 1835

FABEN GILSTRAP

County Cowley State Kansas
 Sec. 32 (Blk. 34 (Sur. 3E Map No. 34 (Twp. Rge.)
 Operator Texas Company
 Well No. 11 Farm L. M. Bryant "C"
 Elev. Location SW SE SE

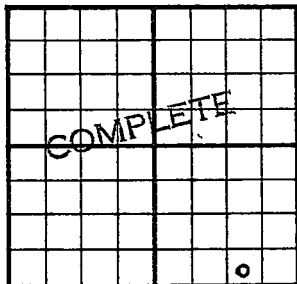

330 Ft. From S Line SE
990 Ft. From E Line Quarter
 1st. Report
 Completion APR 13 1955
 Remarks Gibson Pool
Capitt - Contr.
 Spudding Date 2-25-55

Drilg. Data Oil well TD 3815
10" @ 128 Haskell 2209 Stal. 2255
Layton 2671 KC 2901 Marm. 3072
Cherokee 3190 Peru 3193 DST 2997-
3040 open 1 hr. Rec. 15' gom 54#
Skinner 3248 Bart. 3393 Miss. 3412
Simp. 3736 Simp. sd. 3769 Arb. 3808
TD 3815 7" @ 3807 CO to 3815
300 A F/ 24 bo 6 hr. F/ 103 bopd
F/ 13 bo 2. hr. Comp. 68 bopd

FABEN GILSTRAP