

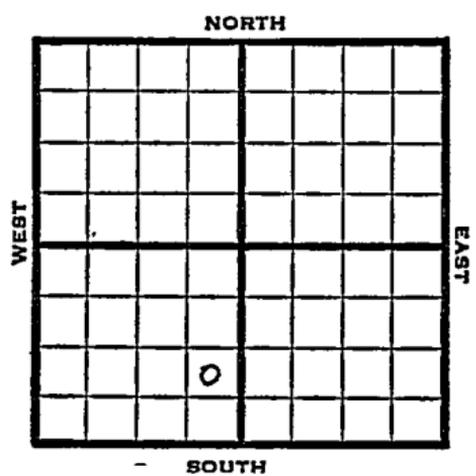
Sec. 32 Twp. 34 R. 3E

Well No. #1 WILLIAMS
#1 M. G. Nelson Farm

Texas Company Company

Laura Jane Contractor
Gibson Pool

 Ft. from N. Line
990 Ft. from S. Line
330 Ft. from E. Line
 Ft. from W. Line
NE SE SW



1952 Elev. 1148' REPORT

10/1 Spud 9-27-52
10" @ 111
Drlg. 800

10/22 Spud 9-27-52
D & A TD 3545' 10" @ 111
KC 2866' Marm. 3068' Bart. 3337'
Miss. 3409'
DST 3414-50 open 1 hr. gas in 22 min.
rec 80' oil
DST 3486-3501 open 1 1/2 hr, rec 360' mud
& SW.
TD 3545' D & A

ABANDONED
O.W.D.D

1954

5/12 Layton 2674', Miss 3409'
TD 3450'
DD
DST 3792'-3810' opn 1/2 hr, rec 7' Mud
50#
DST 3771'-81' opn 1 hr, rec 300' oil
60' Muddy Wtr. Arb 3820'
TD 3833'
7" @ 3832'
WOC.

OVER

1954
12/ 7

Oil well

TD 3833

Layton 2674-Miss. 3409

TD 3450

DST 3792-3810 open 1 hr. Rec. 76
mud 50#

DST 3771-81 opeb 1 hr. Rec. 300'
oil 60' muddy wtr. A

, Arb 3820

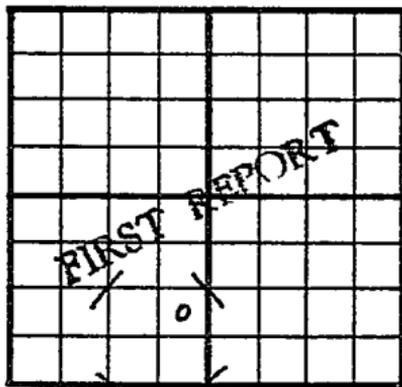
TD 3833

7" : 3832 CO to 3821 20/ 3814-19

500 A S/ 400 bw 19/ 3774-80 S/ 17 bo

3 bw 9 hr. P/ 17 bo 8 hr. Comp. 18
bopd

COMPLETED

County Cowley State KansasSec. 32 (Blk. Twp.) 34 (Sur. Rqs.) 3E Map No.Operator Texas CompanyWell No. 1 Farm M. G. NelsonElev. _____ Location NE SE SW990 Ft. From S Line SW330 Ft. From E Line Quarter1st. Report OCT 1 1952

Completion _____

Remarks _____

Laura Jane - Contr.Spudding Date 9-27-52

Drlg. Data _____

Gibson Pool10" @ 111 drlg. 800

Kansas

Map No. _____ Sec. 32 Twp. 34 R. 3EWell No. 1 Williams

Texas Company _____ Company

CORRECTION _____ Contractor

NE SE SW

SECTION PLAT

_____ Ft. from N. Line

990 Ft. from S. Line330 Ft. from E. Line

_____ Ft. from W. Line

	0		

Cowley County

Location _____

Rig up _____

Drilling and Remarks:

Reported

#1 M.G. Nelson

RECORD

Cased _____ in., _____ ft.

Sand _____

Gas _____

Oil _____

Total Depth _____

PRODUCTION

1st 24 hrs. Nat. _____

1st 24 hrs. after shot _____

Gas _____ Cu. Ft.

Dry Hole _____

Abandoned _____

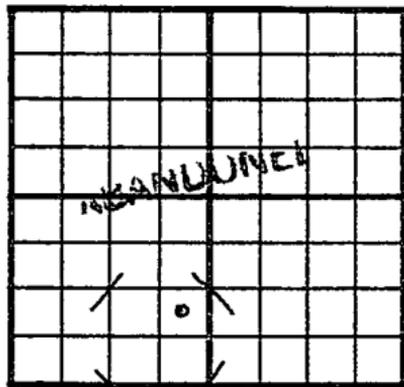
Date

OCT 22 1952

19

J. G. McGEHEE

Scout

County Cowley State KansasSec. 32 (Blk. Twp.) 34 (Sur. Rge.) 3E Map No.Operator Texas CompanyWell No. 1 Farm WilliamsElev. 1148 Location NE SE SW990 Ft. From S Line SW330 Ft. From E Line Quarter1st. ReportCompletion OCT 22 1952Remarks Gibson PoolLaura Jane - Contr.Spudding Date 9-27-52Drlg. Data D & A TD 354510" @ 111 KC 2866 Marm. 3068Bart. 3337 Miss. 3409 DST 3414-50open 1 hr. gas in 22 min. Rec. 80' oilDST 3486-3501 open 1½ hr. Rec. 360'mud & sw TD 3545D & A

