

KANSAS


Butler

Section 20 Township 28 Range 4E

Well No. 2 Smith

Company Thrifty Drlg.

Misc.
NORTH

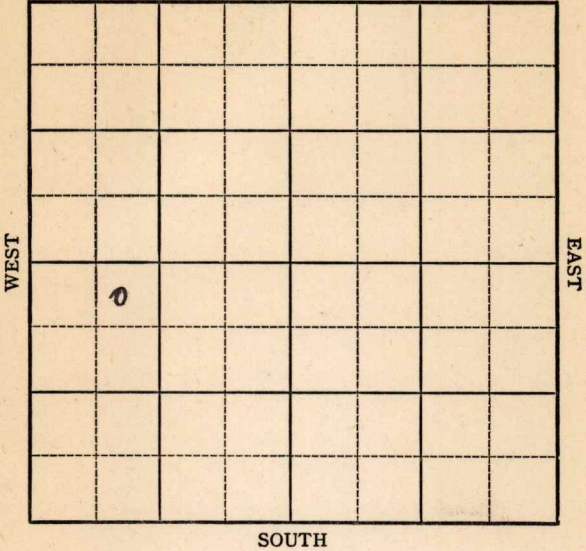

Sec. 20 Twp. 28 R. 4E ✓

Well No. #2 Smith Farm _____

Thrifty Drlg. Company _____


Miscellaneous (Thrifty Drlg. Cont.) NORTH

330' Ft. from N. Line

_____ Ft. from S. Line

_____ Ft. from E. Line

990' Ft. from W. Line

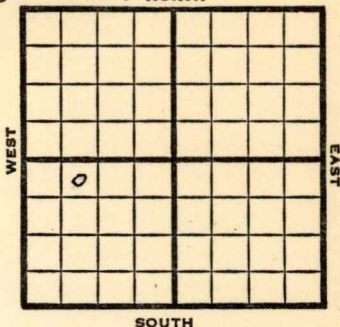

NE NW SW

SOUTH

1949

Elev. 1261' REPORT

7/6

RUR

7/12

8" @ 80'
Drlg. 1520'

7/20

KC 2033'
Arb. 2465'-66'
TD 2466'
5"@ 2465'

7/27

Arb 2465'
5" @ 2465'
Acid 500
Pump 40 oil Pot.
Gr. 38°
TD 2477'

COMPLETED

Map No. _____ Sec. 20 Twp. 28 R. 4E

Well No. 2 Smith

Thrifty Drlg. _____ Company

Thrifty Drlg. _____ Contractor

NE NW SW

FIRST REPORT
SECTION PLAT

330 Ft. from N. Line

_____ Ft. from S. Line

_____ Ft. from E. Line

990 Ft. from W. Line

| | | | |
|--|--|--|--|
| | | | |
| | | | |
| | | | |
| | | | |

Butler County

Location _____

Rig up _____

Drilling and Remarks:

R U R

RECORD

Cased _____ in., _____ ft.

Sand _____

Gas _____

Oil _____

Total Depth _____

PRODUCTION

1st 24 hrs. Nat. _____

1st 24 hrs. after shot _____

Gas _____ Cu. Ft.

Dry Hole _____

Abandoned _____

Date

JUL 6 1949 19 _____

S. J. LEWIS Scout

Kansas

Miscellaneous

Map No. K11 Sec. 20 Twp. 28 R. 4E

Well No. 2 Smith

Thrifty Drlg. Company

COMPLETE

Contractor

NE NW SW

E11261

SECTION PLAT

| | | | |
|--|--|--|--|
| | | | |
| | | | |
| | | | |
| | | | |
| | | | |

330 Ft. from N. Line

_____ Ft. from S. Line

_____ Ft. from E. Line

990 Ft. from W. Line

Butler County

Location _____

Rig up _____

Drilling and Remarks:

CR 2465
5" @ 2465
500 acid
Plug 4000 ft.
380 ft

RECORD

Cased _____ in., _____ ft.

Sand _____

Gas _____

Oil _____

Total Depth 2477

PRODUCTION

1st 24 hrs. Nat. _____

1st 24 hrs. after shot _____

Gas _____ Cu. Ft.

Dry Hole _____

Abandoned _____

Date

JUL 27 1949 19

S. J. LEWIS Scout