


DX 78-1

Section 20 Township 28 Range 1E

Well No. 3 Smith

Company H & M Drlg.

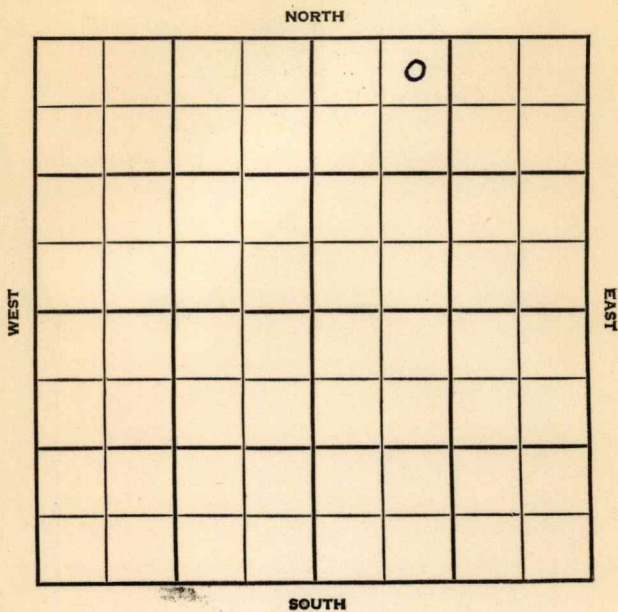

Butler

KANSAS

SEC.	TWP.	R.
20	28	4 E

WELL NO. # 3 Smith FARM

COMPANY H & M Drlg.


CONTRACTOR H & M Drlg.

170 Augusta Pool Ft. from N. Line

Ft. from S. Line

Ft. from E. Line

1190 Ft. from W. Line

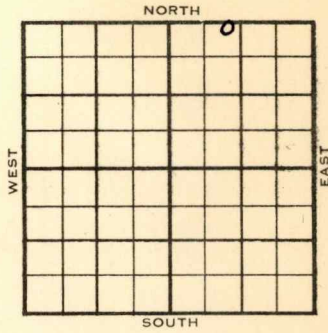

NE NW NE

CSO Farmout

	ELEVATION	REPORT
1954	-	

8/4 Location

9/1 Oil Well
 TD 2575'
 KC 1882', Viola 2422', Arb. 2462'
 TD 2575'
 5" @ 2575'
 CO to 2533'
 w/2477-78 wtr.
 PB 2471 6/2440-42, 1500A
 FU 1100' oil, 1100' wtr.
 Comp. 25 bopd 25 bw

COMPLETED

County Butler State Kansas

Sec. 20 (Blk. 28) (Sur. 4E) (Rge.) Map No.

Operator H & M Drlg.

Well No. 3 Farm Smith

Elev. Location NE NW NE

170Ft. From N Line NE

1190Ft. From W Line Quarter

1st. Report

Completion SEP 1 1954

Remarks Augusta Pool

H & M Drlg. - Contr.

Spudding Date

Drlg. Data Oil well TD 2575

KC 1882 Viola 2422 Arb. 2462

TD 2575 5" @ 2575 CO to 2533

3/ 2477-78 wtr. PB 2471 6/ 2440-42

1500 A FU 1100' oil 1100' wtr/

Comp. 25 bopd 25 bw

COMPLETE

