

KANSAS

Cowley

Form 51-5M-7-40-Palace

Section 35 Township 30 Range 4-E

Well No. 1 Cash

Company ~~Nadel et al~~ Arthur Brewer et al

Rock Pool

NORTH

WEST

EAST

SOUTH

0

Sec. 35 Twp. 30 R. 4-E

Well No. #1 Cash Farm

~~Nadel et al~~ Arthur Brewer Company

(Rock)


etal
NORTH

_____ Ft. from N. Line

330 Ft. from S. Line

990 Ft. from E. Line

_____ Ft. from W. Line

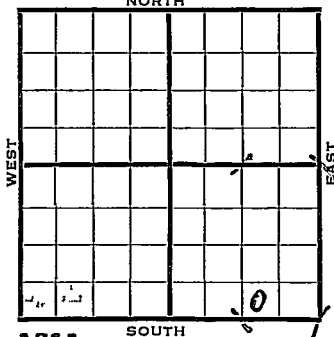

Elev. 1311

1941	REPORT
1/29	Spud - Cable.
2/6	390' fsg. tools.
2/13	15" - 440' 12" - 1076' Drlg. 1390'
2/20	10" - 1780' Drlg. 1880'
2/27	8" - 2099' K.C. 2375' Drlg. 2630'
3/6	Bart. 2980' T.D. 3000' SD. No shows.
3/12	Bart. 2980' 6" - 2710' T.D. 3000' No shows.
	ABANDONED

Map No. 11 Sec. 35 Twp. 30 R. 4EWell No. 1 CashArthur Brewer etal CompanyABANDONED Contractor

SW SE SE

 Ft. from N. Line330 Ft. from S. Line990 Ft. from E. Line Ft. from W. Line

ROCK POOL

SECTION PLAT

			o

Location Rig up

Drilling and Remarks:

*Bar 2980**6" @ 2710**No shows*

RECORD

Cased in., ft.Sand Gas Oil Total Depth 3000

PRODUCTION

1st 24 hrs. Nat. 1st 24 hrs. after shot Gas Cu. Ft.Dry Hole Abandoned

Date

MAR 12 1941 19S. J. LEWIS Scout