


Map No. **KANSAS** Sec. *35* Twp. *30* R. *4E*

Well No. *1- Davis (David)* Farm  
*Roth & Faurot et al* Company

*Cowley*

NORTH

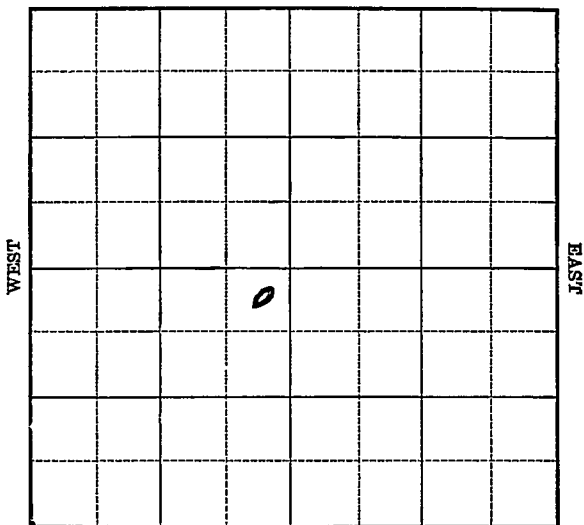

SOUTH

Location \_\_\_\_\_

Drilling Remarks \_\_\_\_\_  
\_\_\_\_\_  
\_\_\_\_\_  
Rig Up \_\_\_\_\_

Drilling Remarks \_\_\_\_\_  
\_\_\_\_\_  
\_\_\_\_\_  
**RECORD**

Cased \_\_\_\_\_ in. \_\_\_\_\_ ft.

Sand \_\_\_\_\_

Gas \_\_\_\_\_

Oil \_\_\_\_\_

Total Depth \_\_\_\_\_

**PRODUCTION**

1st 24 hrs. Nat. \_\_\_\_\_

1st 24 hrs. after shot \_\_\_\_\_

Gas \_\_\_\_\_ cu. ft.

Dry Hole \_\_\_\_\_


Abandoned \_\_\_\_\_

Cowley

Map No. KANSAS Sec. 35 Twp. 30 R. 4E

Well No. 1- Davis Farm  
Roth & Faurot et al Company

330 Ft. from N. Line  
\_\_\_\_ Ft. from S. Line  
330 Ft. from E. Line  
\_\_\_\_ Ft. from W. Line

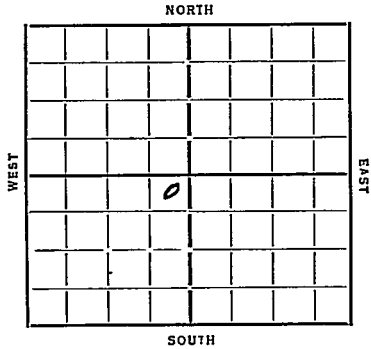

Date	REPORT
1985	
4/17	Rig
4/26	<del>5/2</del>
5/9	Rig
5/16	<del>5/23</del>
5/29	Spud
6/6	Relg 440 15" 400
6/13	" 750
6/20	" 960
6/28	" 1345
7/3	" 1440
7/14	" 1595
7/18	—
8/8	Relg 2940 6" 2690
8/15	BOA 2953-73 TD 2975 HFO 14 hrs.
8/22	— 8/29
9/6	324 Bobs 24 hrs.
9/20	haul 2953 TD 2975 215 Bobs

COMPLETED

Map No. 11 Sec. 35 Twp. 30 R. 4 E

Well No. 1-Davis

Roth + Traut et al Company

Contractor

**FIRST REPORTS**

**SECTION PLAT**

330 Ft. from N. Line  
 \_\_\_\_\_ Ft. from S. Line  
330 Ft. from E. Line  
 \_\_\_\_\_ Ft. from W. Line

	0		

Location \_\_\_\_\_  
 Rig up \_\_\_\_\_  
 Drilling and Remarks:

*Rog*

**RECORD**

Cased \_\_\_\_\_ in., \_\_\_\_\_ ft.  
 Sand \_\_\_\_\_  
 Gas \_\_\_\_\_  
 Oil \_\_\_\_\_  
 Total Depth \_\_\_\_\_

**PRODUCTION**

1st 24 hrs. Nat. \_\_\_\_\_  
 1st 24 hrs. after shot \_\_\_\_\_  
 Gas \_\_\_\_\_ Cu. Ft.  
 Dry Hole \_\_\_\_\_  
 Abandoned \_\_\_\_\_

Date

4-17-35 192

**ORVAL MANNSCHRECK**

Scout

Cowley  
Form 26-101 Bks. 9-28

Map No. 11 Sec. 35 Twp. 30 R. 4E

Well No. 1-Davis

Roth & Opaurot Company

KANSAS

Contractor

COMPLETED

330 Ft. from N. Line

Ft. from S. Line

330 Ft. from E. Line

Ft. from W. Line

SECTION PLAT

	0		

Location

Rig up

Drilling and Remarks:

215 lbs

RECORD

Cased in ft.

Sand 2953

Gas

Oil

Total Depth 2975

PRODUCTION

1st 24 hrs. Nat.

1st 24 hrs. after shot

Gas Cu. Ft.

Dry Hole

Abandoned

Date

9-20-35 192

ORVAL MANNING Scout