


Ellis

DX 78-1

Section 5 Township 14 Range 19W **KANSAS**
Well No. #2 Furthmeyer
Company Strain Drlg.

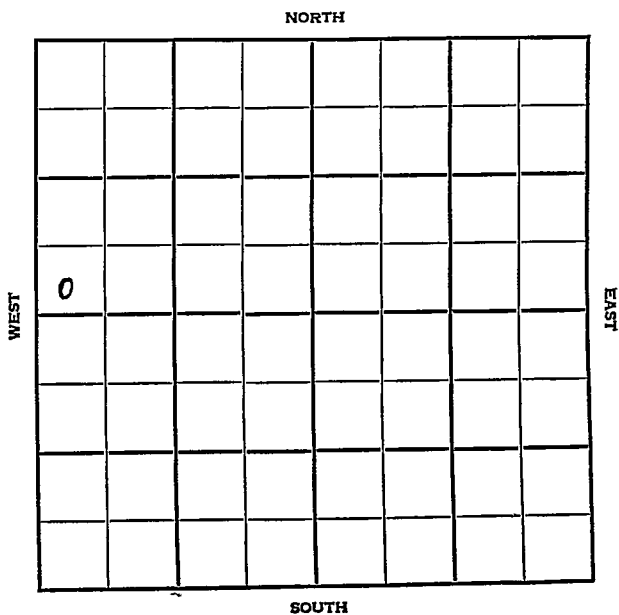

Ellis KANSAS


SEC. 5 TWP. 14 R. 19W ✓

WELL NO. 2 Furthmeyer FARM

COMPANY Strain Drlg.

CONTRACTOR Strain Drlg.

Irvin Pool
 _____ Ft. from N. Line
 330 _____ Ft. from S. Line
 _____ Ft. from E. Line
 330 _____ Ft. from W. Line
 SW SW NW

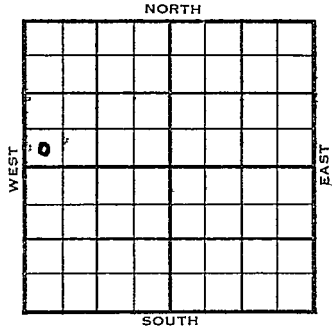

1954 ELEVATION 2266' REPORT

4/27 Cellar & Pits
 5/5 8" @ 185 w/125 Top 3251'
 Drlg. 3256'
 5/12 NR
 5/19 Heeb 3510 Tor. 3532 Lans 3554
 B KC 3803 Cong. 3844 Arb. 3879
 RTD 3889 5" @ 3881
 6/2 Spud 4-27-54
 Oil Well
 TD 3889'
 8" @ 185'
 Anhy 1541', Top 3251'; Heeb 3510',
 Tor 3532', Lans 3554', B KC 3803',
 Cong 3844', Arb. 3879'
 TD 3889'
 5" @ 3881'
 CO to 3884'
 S/2 boph 500A
 S/15 boph 2 hrs.
 Comp. 50 bopd

COMPLETED

