
Ellis KANSAS

SECTION 5 TOWNSHIP 14 RANGE 19W

WELL NO. #2 Gus Riedel "B"

COMPANY Stanolind Oil & Gas

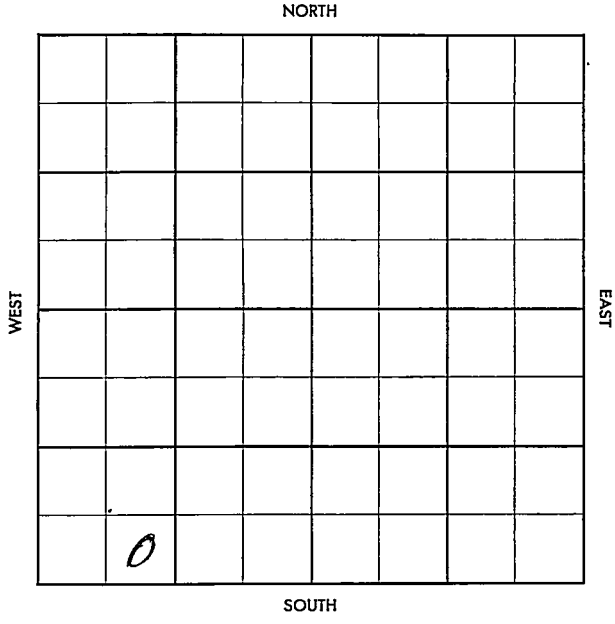

FORM 504-3 SUNRAY

FORM 513 SUNRAY

County Ellis Elev. 2233

Sec. 5 Twp. 14 Rge. 19W

Company Stanolind Oil and Gas

Farm Name Gas Riedel "B" No. 2

TOPS	DEPTH	LOG	DATUM
Anh.			
Tp.			
H.	3476		
Tr.			
Dg.			
Bl.			
L.	3520		
K.C.			
B.K.C.			
Ce.			
C.			
M.			
M.			
K.			
Mz.			
Mo.			
V.			
S.			
S.			
A	3850		
R.			
P€.			
G.			
T.D.	3927		

Loc. in Sec. SE SW SW

Geol.

Contr. Prime Drlg.

Pool Irvin

COMPLETE

NOV 29 '56

Date Comm. spd. 10-13-56

8" @ 213 w/150, WOC oci 24 '56 TD 3270

DST 3536-59 1hr. 42' SOCM

BHP 530/20" DST 3590-3601

1hr 14' SOCM BHP 0/20" DST

3696-3708 1hr 5' Md BHP 90

cr9 @ 3886 NOV 7 '56 DST 3877-86

1hr 265' Wtr (550) BHP 955/20"

5½ 3925/250 co 3877 16/3872-74

acc 4 GMCW + Tr. oil 2 hrs. Na

& Ld NOV 13 '56

FORM 513-1 SUNRAY

~~ord 3829 - 50 acre ft~~ SGd

co 3877 tst dry 16/3872
-74/12 ~~acre~~ tst 12.7 BF ph
est 10% wtr. tstg NOV 21 '56 P.
147.80 + 9 BW 24 hrs NOV 28 '56
Ph P 165 Bond + 7% wtr.

5-14-19 se sw sw

FORM 513 SUNRAY

County Ellis Elev.

Sec. 5 Twp. 14 Rge. 19W

Company Stanolind Oil and Gas

Farm Name Gus Riedel "B" No. 2

TOPS	DEPTH	LOG	DATUM
Anh.			
T.P.			
H.			
Tr.			
Dg.			
B.L.			
L.			
K.C.			
B.K.C.			
Ce.			
C.			
M.			
M.			
K.			
Mz.			
Mc.			
V.			
S.			
S.			
A			
R.			
P€.			
G.			
T.D.			

Loc. in Sec. SE SW SW

Geol.

Contr. Prime Drlg.

Pool Irvin

FIRST REPORT

OCT 4 1956

0

Date Comm. spd. 10-13-56

8" @ 213 w/150, WOC

Co. Lse. No. Sec. T. R.