

Section 5 Township 14 Range 19W

Well No. 1 M. Furthmeyer

Company Stanolind

Irvin

NORTH

| | | | | | | | |
|--|---|--|--|--|--|--|--|
| | | | | | | | |
| | | | | | | | |
| | | | | | | | |
| | 0 | | | | | | |
| | | | | | | | |
| | | | | | | | |
| | | | | | | | |
| | | | | | | | |

WEST

EAST

SOUTH

KANSAS

Ellis ✓

Sec. 5 Twp. 14 R. 19W

Well No. #1 M. Furthmeyer Farm

Stanolind Company

Irvin Pool


_____ Ft. from N. Line

330' Ft. from S. Line

_____ Ft. from E. Line

990' Ft. from W. Line

Irvin Pool

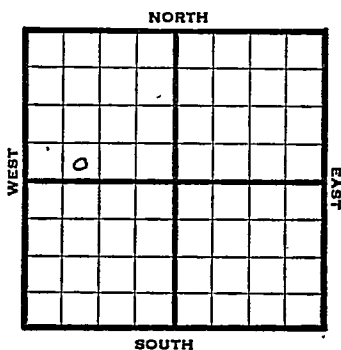

1948 Elev. 2251' REPORT

- 3/3 Location
- 3/17 "
- 3/24 "
- 3/31 13" @ 149'
WOC
- 4/7 Drlg. 3262'
- 4/14 Lansing 3532'
Drlg. 3876'
- 4/21 Arbuckle 3910'
Granite 4070'
TD 4079'
5" @ 3945'
RUST
- 4/28 Arb. 3910'
Granite 4070'
5" @ 3445'
SWD
TD 4079'

ABANDONED

Map No. _____ Sec. 5 Twp. 14 R. 19W

Well No. 1 M. Furthmever

Stanolind Company

FIRST REPORT Contractor

SE SW NW


_____ Ft. from N. Line

330 Ft. from S. Line

_____ Ft. from E. Line

990 Ft. from W. Line

SECTION PLAT

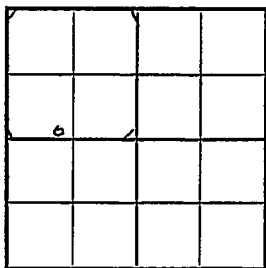

Ellis County

Location X

Rig up _____

Drilling and Remarks:

RECORD

Cased _____ in., _____ ft.

Sand _____

Gas _____

Oil _____

Total Depth _____

PRODUCTION

1st 24 hrs. Nat. _____

1st 24 hrs. after shot _____

Gas _____ Cu. Ft.

Dry Hole _____

Abandoned _____

Date

MAR 3 1948

19

S. J. LEWIS Scout

Map No. 70 Sec. 5 Twp. 14 R. 19W

Well No. 1 M. Furthmeyer

Stanolind Company

ABANDONED

Contractor

SE SW NW

E1,225/
SECTION PLAT

 Ft. from N. Line

330 Ft. from S. Line

 Ft. from E. Line

990 Ft. from W. Line

| | | | |
|--|--|--|--|
| | | | |
| | | | |
| | | | |
| | | | |
| | | | |

Ellis County

Location

Rig up

Drilling and Remarks:

CR 88910
Grants 4070
5" @ 3445
BWJ

RECORD

Cased in., ft.

Sand

Gas

Oil

Total Depth 4079

PRODUCTION

1st 24 hrs. Nat.

1st 24 hrs. after shot

Gas Cu. Ft.

Dry Hole

Abandoned

Date

APR 28 1948

S. J. LEWIS Scout