


Section 35 Township 30 Range 4-E

Well Number 2-David


Company Palmer

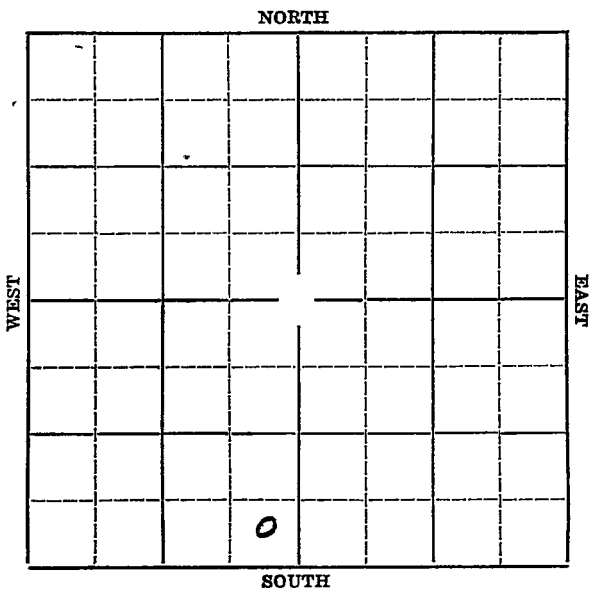

Map No. KANSAS Sec. 35 Twp. 30 R. 4E

Well No. #2 David Farm _____
Palmer Company

_____ Ft. from N. Line
330' Ft. from S. Line
330' Ft. from E. Line
_____ Ft. from W. Line

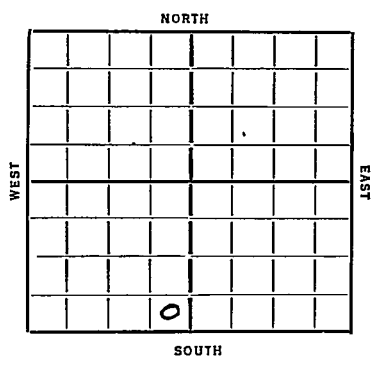

Elev. 1290

Date	REPORT
1936 4/22	Machine.
5/8	Drlg. 383'.
5/14	--- SHUT DOWN.
5/21	1545'. Cleaning out.
5/28	Drlg. 2038'.
6/4	Drlg. 2510'.
6/11	Drlg. 2945'.
6/18	Shut down.
6/25	--- 7/2-- 7/9--
7/16	Not this deep. K.C. 2330'. T.D. 2700'. U.R. 6".
7/23	2875'. Shut down.
7/29	/36-Sand 2852' (CORRECTED)
	T.D. 2871'.
	10 qts shot.
	Dry and abandoned.
	ABANDONED

County Osage
Map No. 11 Sec. 35 Twp. 30 R. 4EWell No. 2 DavidPalmer Company

Contractor

SECTION PLAT

.....Ft. from N. Line

320 Ft. from S. Line330 Ft. from E. Line

.....Ft. from W. Line

FIRST REPORT

Location.....

Rig up.....

Drilling and Remarks:

Match.

RECORD

Cased.....in.,ft.

Sand.....

Gas.....

Oil.....

Total Depth.....

PRODUCTION

1st 24 hrs. Nat.....

1st 24 hrs. after shot.....

Gas.....Cu. Ft.

Dry Hole.....

Abandoned.....

Date

APR 22 1927

192

OSAGE

Scout

Map No. 111 Sec. 35 Twp. 30 R. 4E

Well No. 2 David

Palmer Company

Contractor

SECTION PLAT

 Ft. from N. Line

230 Ft. from S. Line

230 Ft. from E. Line

 Ft. from W. Line

ABANDONED

Location

Rig up

Drilling and Remarks:

*Sand 2852 corrected
10 g to s h r 8.*

JYA

RECORD

Cased in., ft.

Sand

Gas

Oil

Total Depth 2871

PRODUCTION

1st 24 hrs. Nat.

1st 24 hrs. after shot

Gas Cu. Ft.

Dry Hole

Abandoned

Date

JUL 29 1936₁₉

S. J. LEWIS Scout,