

KANSAS


FORM 51 5M BR1X

Cowley County

Section 35 Township 30 Range 4E

Well No. #3 David

Company Aylward Prod

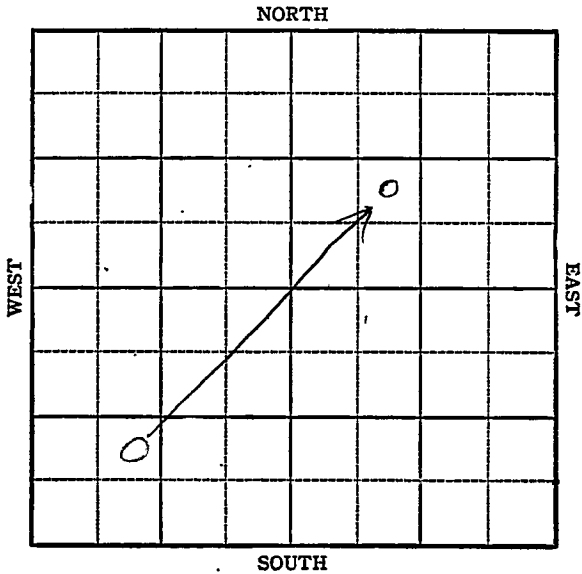

KANSAS

Cowley County

Sec. 35 Twp. 30 R. 4E

Well No. #3 David Farm

Aylward Prod. Company


Miscellaneous

 Ft. from N. Line

990 Ft. from S. Line

 Ft. from E. Line

990 Ft. from W. Line

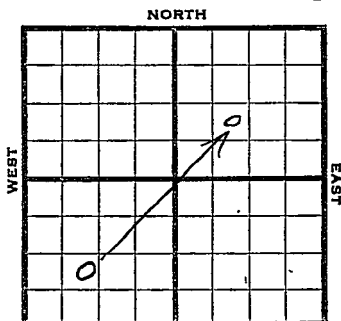

NE SW ~~SW~~ NE Elev. 1315 SOUTH

R E P O R T

1944

11/15 Location

11/24 Drlg. 420

11/29 15" @ 4351 12" @ 1028 Drlg. 1300

12/6 10" @ 1608' Drlg. 1880'

12/14 8" @ 2085' Drlg. 2425'

12/21 6" @ 2506'

TD 2910' Run 5"

12/29 Bart 2963

TD 2991

5" @ 2966'

1945

1-3 Bartlesville 2963

Total Depth 2991

5" @ 2966

ABANDONED

Pool Name MiscellaneousMap No. 11 Sec. 35 Twp. 30 R. 4EWell No. 3 DavidAylward Prod CompanyFIRST REPORT Contractor

NE SW SW

SECTION PLAT

 Ft. from N. Line990 Ft. from S. Line Ft. from E. Line990 Ft. from W. LineGowleyLocation XRig up

Drilling and Remarks:

RECORD

Cased in., ft.Sand Gas Oil Total Depth

PRODUCTION

1st 24 hrs. Nat. 1st 24 hrs. after shot Gas Cu. Ft.Dry Hole Abandoned

Date

NOV 15 1944 19S. J. LEWIS Scout

