

Russell


KANSAS

Form 51-5M 5-37 Petrol

Section 25 Township 15 Range 14-W

Well No. 8 - Boomhower

Company Empire

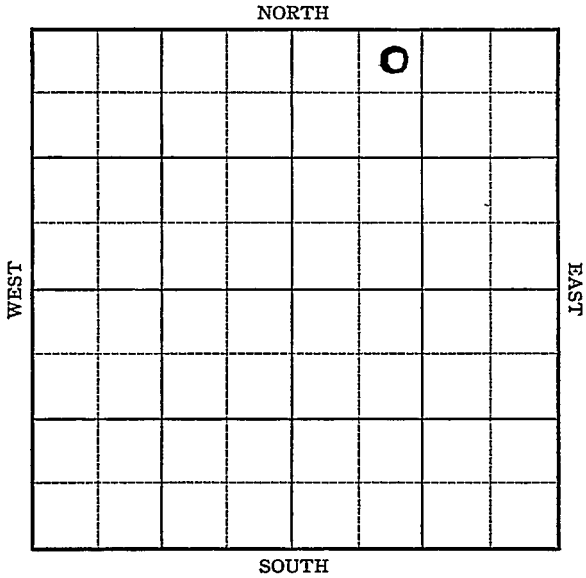

Sec. 25 Twp. 15 R. 14-W

Well No. #8 Boomhower Farm


Company

330 Ft. from N. Line

_____ Ft. from S. Line

Ft. from E. Line

990 Ft. from W. Line

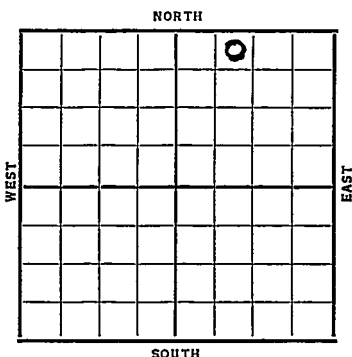[illegible]

KANSAS

Russell

Map No. _____ Sec. 25 Twp. 15 R. 14^WWell No. 8-BoomhowerEmpire Company
Contractor

FIRST REPORT

SECTION PLAT

330 Ft. from N. Line

_____ Ft. from S. Line

_____ Ft. from E. Line

990 Ft. from W. Line

		0	

Location _____

Rig up _____

Drilling and Remarks:

R.R.

RECORD

Cased _____ in., _____ ft.

Sand _____

Gas _____

Oil _____

Total Depth _____

PRODUCTION

1st 24 hrs. Nat. _____

1st 24 hrs. after shot _____

Gas _____ Cu. Ft.

Dry Hole _____

Abandoned _____

Date

JUL 28 1937

19

H. D. Hatfield Scout

Russell KANSAS

Map No. _____ Sec. 25 Twp. 15 R. 14^WWell No. 8-BoornhowerEmpire Company_____
Contractor

COMPLETED

SECTION PLAT

		0	

330 Ft. from N. Line

_____ Ft. from S. Line

_____ Ft. from E. Line

990 Ft. from W. Line

Location _____

Rig up _____

Drilling and Remarks:

2000 AcidPat-2377

RECORD

Cased 7 in., 3321 ft.Sand 511 3322Gas (Corrected)

Oil _____

Total Depth 3326

PRODUCTION

1st 24 hrs. Nat. _____

1st 24 hrs. after shot _____

Gas _____ Cu. Ft.

Dry Hole _____

Abandoned _____

Date

AUG 25 1937 19 H. D. Hatfield Scout