

Map No. _____ Sec. 20 Twp. 28 R. 4
 Well No. 24 Smith Farm _____
Empire Company _____

NORTH

WEST

EAST



SOUTH

Location _____ Rig Up _____

Drilling Remarks: _____ Drilling Remarks: _____

30 Bales (1000) 2475 - 2488

6/4/18

RECORD

Cased _____ in. _____ ft.

Sand _____

Gas _____

Oil _____

Total Depth _____

PRODUCTION

1st 24 hrs. Nat. _____

1st 24 hrs. after shot _____

Gas _____ cu. ft

Dry Hole _____

Abandoned _____

Map No. W11 Sec. 20 Twp. 28 R. 4
 Well No. 24 Smith Farm
Cummins Company

NORTH

SOUTH

Location ✓

Rig up ✓

Drilling and remarks:

RECORD

Cased in. Ft.

Sand

Gas

Oil

Total Depth

PRODUCTION

1st 24 hrs. Nat.

1st 24 hrs. after shot

Gas Cu. Ft.

Dry Hole

Abandoned

FIRST REPORT

Date

4/3, 1918, Cummins Scout

Map No. _____ Sec. 20 Twp. 28 R. 4Well No. 24 Smith Farm _____Engine Company _____

NORTH

WEST

EAST

SOUTH

RECORD

Location _____

Cased _____ in. _____ Ft.

Rig Up _____

Sand _____

Drilling and remarks

Gas _____

Oil _____

Total Depth _____

PRODUCTION

1st 24 hrs. Nat. _____

1st 24 hrs. after shot _____

Gas _____ Cu. Ft.

Dry Hole _____

Abandoned _____


Date

4/17, 1911 S. Candy Scout

Map No.----- Sec. 30 Twp. 38 R. 4
Well No. 24 Smith Farm
Enterprise Company

NORTH

WEST

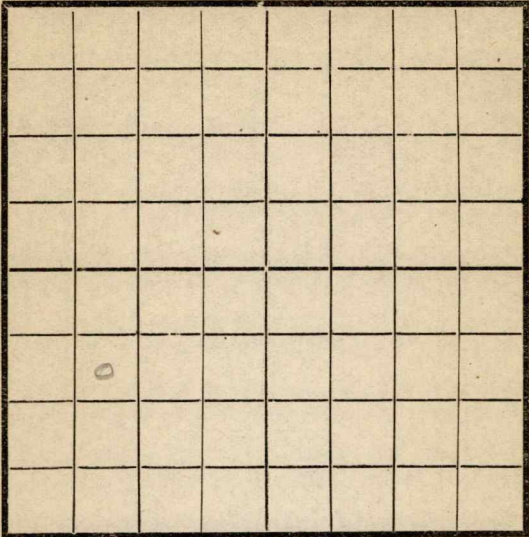

EAST

SOUTH

Location -----
Rig Up -----
Drilling and remarks
350

RECORD


Cased ----- in. ----- Ft.
Sand -----
Gas -----
Oil -----
Total Depth -----

PRODUCTION

1st 24 hrs. Nat. -----
1st 24 hrs. after shot -----
Gas ----- Cu. Ft.
Dry Hole -----
Abandoned -----

Date
4/24, 1918 S. Conley Scout

Map No. _____ Sec. 20 Twp. 28 R. 4
Well No. 24 Quinte Farm _____
Cumprine Company _____
NORTH

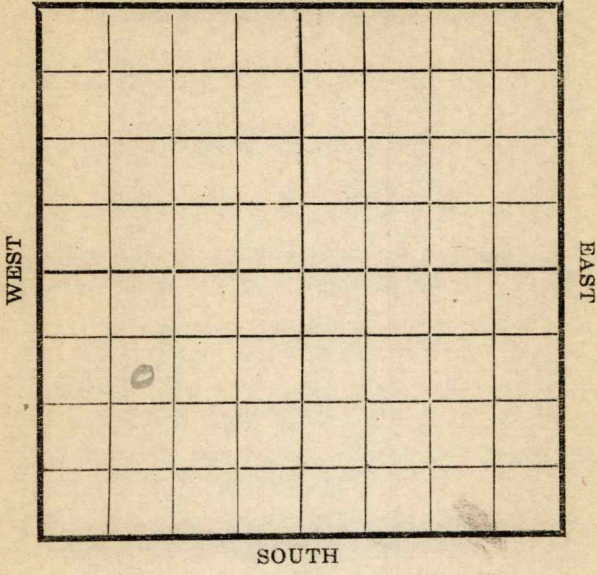

Location _____
Rig Up _____
Drilling and remarks
650

RECORD
Cased _____ in. _____ Ft
Sand _____
Gas _____
Oil _____
Total Depth _____


PRODUCTION
1st 24 hrs. Nat. _____
1st 24 hrs. after shot _____
Gas _____ Cu. Ft.
Dry Hole _____
Abandoned _____

Date 5-1, 1918 Cumprine Scout

Map No. _____ Sec. 20 Twp. 28 R. 4Well No. 24 Smith Farm __________
Empire Company

NORTH

WEST

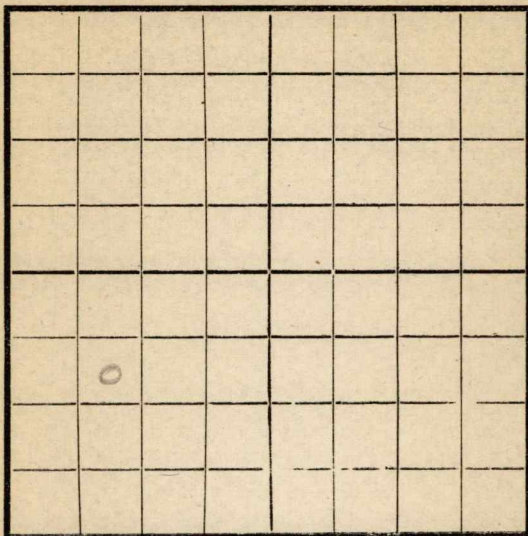

EAST

SOUTH

Location _____

Rig Up _____

Drilling and remarks

1000

RECORD

Cased _____ in. _____ Ft.

Sand _____

Gas _____

Oil _____

Total Depth _____

PRODUCTION

1st 24 hrs. Nat. _____

1st 24 hrs. after shot _____

Gas _____ Cu. Ft.

Dry Hole _____

Abandoned _____


Date

578, 1918 Scout

Map No. _____ Sec. 20 Twp 28 R. 4
 Well No. 24 Smith Farm _____
Engine Company _____

NORTH

WEST

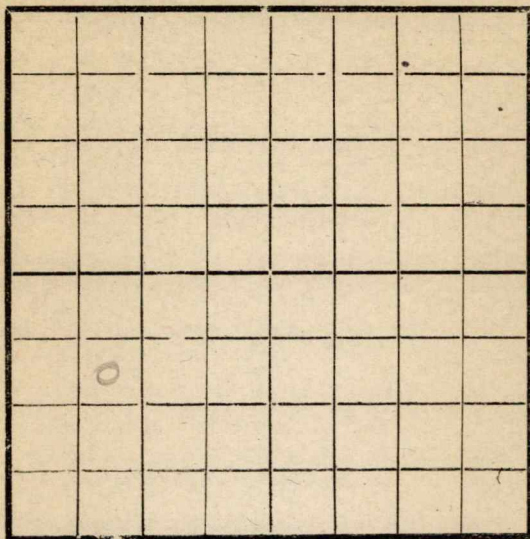

EAST

SOUTH

Location _____

Rig Up _____

Drilling and remarks

1385

RECORD

Cased _____ in. _____ Ft.

Sand _____

Gas _____

Oil _____

Total Depth _____

PRODUCTION

1st 24 hrs. Nat. _____

1st 24 hrs. after shot _____

Gas _____ Cu. Ft.

Dry Hole _____

Abandoned _____

Date

5/15, 1918 J. C. Cuddy Scout


Map No. _____ Sec. 20 Twp. 28 R. 4

Well No. 24 Smith Farm _____

Empire Company _____

NORTH

WEST

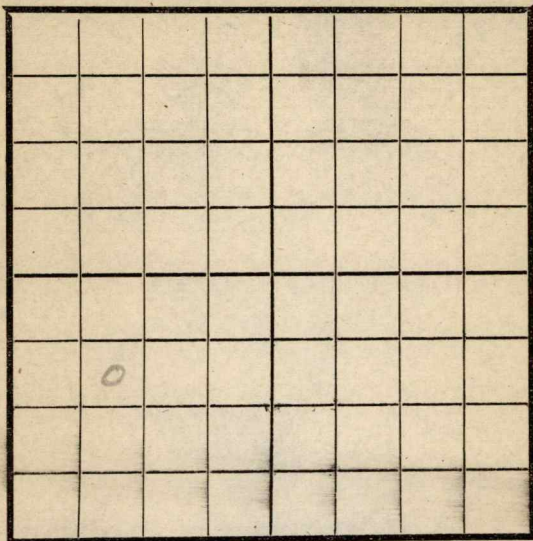

EAST

SOUTH

Location _____

Rig Up _____

Drilling and remarks

1925

RECORD

Cased _____ in _____ Ft.

Sand _____

Gas _____

Oil _____

Total Depth _____

PRODUCTION

1st 24 hrs. Nat. _____

1st 24 hrs. after shot _____

Gas _____ Cu. Ft.

Dry Hole _____

Abandoned _____

Date

5/22, 1918 Landry

Scout


Map No. _____ Sec. 20 Twp. 28 R. 4

Well No. 24 Smith Farm _____

Empire Company _____

NORTH

WEST

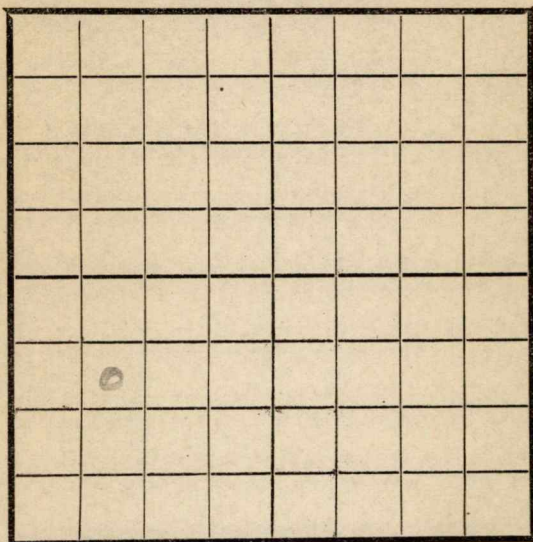

EAST

SOUTH

Location _____

Rig Up _____

Drilling and remarks

RECORD

Cased _____ in. _____ Ft.

Sand _____

Gas _____

Oil _____

Total Depth _____

PRODUCTION

1st 24 hrs. Nat. _____

1st 24 hrs. after shot _____

Gas _____ Cu. Ft.

Dry Hole _____

Abandoned _____

Date

5/39, 1911 S. Carby Scout


1002 K11 Map No. Sec. 20 Twp. 28 R. 4

Well No. 24 Smith Farm

Company
Empire

NORTH

WEST

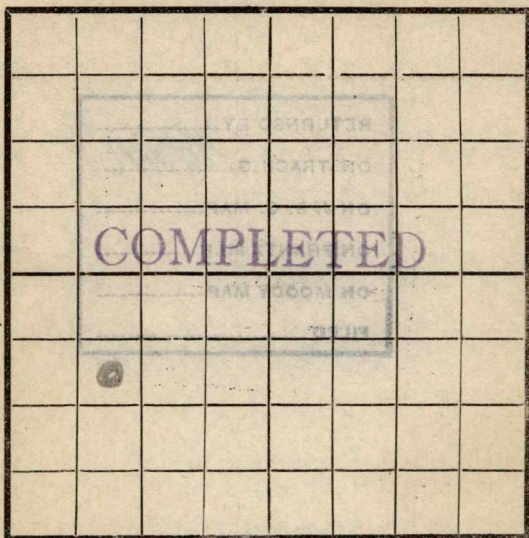

EAST

SOUTH

Location -----

Rig Up -----

Drilling and remarks

Est at
30
feet

RECORD

Cased ----- in. ----- Ft.

Sand 2475-2488

Gas -----

Oil -----

Total Depth -----

PRODUCTION

1st 24 hrs. Nat. -----

1st 24 hrs. after shot -----

Gas ----- Cu. Ft.

Dry Hole -----

Abandoned -----

Date

6/4, 1918 Condy Scout